

STATE OF KANSAS
STATE CORPORATION COMMISSION
Give All Information Completely
Make Required Affidavit
Mail or Deliver Report to:
Conservation Division
State Corporation Commission
211 No. Broadway
Wichita, Kansas

WELL PLUGGING RECORD

Sedgwick County. Sec. 23 Twp. 29S Rge. 1W (E) (W)

Location as "NE/CNW/SW" or footage from lines SW-SW-NE 1/4

Lease Owner Consolidated Gas & Mining Corp. and Harvest Queen Mill &

Lease Name Elevator Company Roy Well No. 1-D

Office Address P. O. Box 1191, Plainview, Texas

Character of Well (completed as Oil, Gas or Dry Hole) Dry Hole

Date well completed _____ 19__

Application for plugging filed _____ 19__

Application for plugging approved _____ 19__


Plugging commenced January 24, 19 58

Plugging completed January 29 19 58

Reason for abandonment of well or producing formation Dry

If a producing well is abandoned, date of last production _____ 19__

Was permission obtained from the Conservation Division or its agents before plugging was commenced? Yes

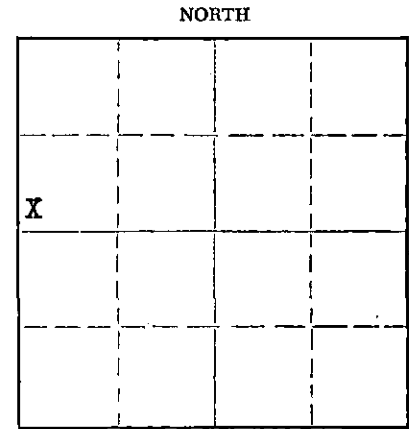

Locate well correctly on above Section Flat

Name of Conservation Agent who supervised plugging of this well Ruel Durkee

Producing formation Simpson Test Depth to top _____ Bottom _____ Total Depth of Well 3,755 Feet

Show depth and thickness of all water, oil and gas formations.

OIL, GAS OR WATER RECORDS

CASING RECORD

| FORMATION | CONTENT | FROM | TO | SIZE | PUT IN | PULLED OUT |
|-----------|---------|------|----|--------|--------|------------|
| | | | | 9" | 230' | 0 |
| | | | | 5-1/2" | 3,755' | 2,797' |
| | | | | | | |
| | | | | | | |
| | | | | | | |
| | | | | | | |
| | | | | | | |

Describe in detail the manner in which the well was plugged, indicating where the mud fluid was placed and the method or methods used in introducing it into the hole. If cement or other plugs were used, state the character of same and depth placed, from _____ feet to _____ feet for each plug set.

Filled back with gravel to 3690'. Dumped 6 sacks of cement. Shot pipe off at 2797'. Pulled pipe and mudded hole to 225'. Dumped 15 sacks of cement. Finished mudding hole and dumped 5 sacks of cement at base of cellar.

2-24-58

RECEIVED
STATE CORPORATION COMMISSION

FEB 24 1958

CONSERVATION DIVISION
Wichita, Kansas

(If additional description is necessary, use BACK of this sheet)

Name of Plugging Contractor Bert Self

Address Hutchinson, Kansas.

STATE OF Kans. COUNTY OF Reno, ss. Employee (employee of owner) or (owner or operator) of the above-described

well, being first duly sworn on oath, says: That I have knowledge of the facts, statements, and matters herein contained and the log of the above-described well as filed and that the same are true and correct. So help me God.

(Signature) [Signature]
R. R. #4, Hutchinson, Kans.
(Address)

SUBSCRIBED AND SWORN TO before me this 10th day of February, 19 58

My commission expires August 12, 1961 [Signature] Notary Public.

PLUGGING
FILE SEC. 23 T. 29 R. 14
BOOK PAGE 74 LINE 3