


Give All Information Completely
Make Required Affidavit
Mail or Deliver Report to:
Conservation Division
State Corporation Commission
211 No. Broadway
Wichita, Kansas

WELL PLUGGING RECORD

SEDGWICK County, Sec. 22 Twp. 29 Rge. 1 (E) 1 (W)

Location as "NE/CNW/SW" or footage from lines NW-NW-SE
Lease Owner I. O. MILLER
Lease Name CASNER Well No. 1
Office Address 619 BROWN BUILDING, WICHITA, KANSAS
Character of Well (completed as Oil, Gas or Dry Hole) OIL
Date well completed 2-7 19 65
Application for plugging filed 3-29 19 65
Application for plugging approved _____ 19 _____
Plugging commenced 4-1 19 65
Plugging completed 4-2 19 65
Reason for abandonment of well or producing formation DRY

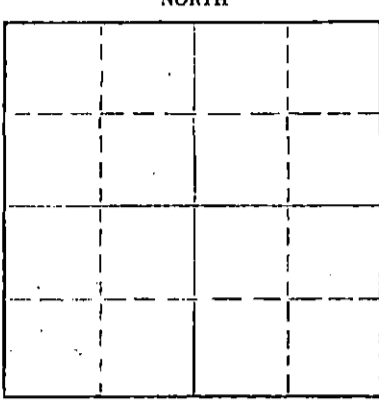

Locate well correctly on above Section Plat

If a producing well is abandoned, date of last production _____ 19 _____
Was permission obtained from the Conservation Division or its agents before plugging was commenced? YES

Name of Conservation Agent who supervised plugging of this well PAUL TURPIN
Producing formation _____ Depth to top _____ Bottom _____ Total Depth of Well 3742 Feet
Show depth and thickness of all water, oil and gas formations.

OIL, GAS OR WATER RECORDS

CASING RECORD

FORMATION	CONTENT	FROM	TO	SIZE	PUT IN	PULLED OUT
				8-5/8"	339'	0
				4 1/2"	3731'	1150

Describe in detail the manner in which the well was plugged, indicating where the mud fluid was placed and the method or methods used in introducing it into the hole. If cement or other plugs were used, state the character of same and depth placed, from _____ feet to _____ feet for each plug set.

PLUG BACK TO 3464', SAND TO 3450'
DUMP 5 SACKS CEMENT
SET ROCK BRIDGE AT 225'
CEMENT TO SURFACE WITH 2 1/2 YARDS RED-MIX

RECEIVED
STATE CORPORATION COMMISSION

APR 15 1965

CONSERVATION DIVISION
Wichita, Kansas

Name of Plugging Contractor WINFIELD OIL FIELD SERVICE, INC.
Address 2011 MAIN, WINFIELD, KANSAS

STATE OF Kansas COUNTY OF Sedgwick, ss.
I.O. Miller, Operator (employee of owner) or (owner or operator) of the above-described

well, being first duly sworn on oath, says: That I have knowledge of the facts, statements, and matters herein contained and the log of the above-described well as filed and that the same are true and correct. So help me God.

(Signature) I.O. Miller
619 Brown Building, Wichita 2, Kansas.
(Address)

Subscribed and Sworn to before me this 14 day of April, 19 65.

My commission expires July 22, 1965
Dee Schack
Notary Public.

GABBERT-JONES INC.
WICHITA, KANSAS
DRILLERS WELL LOG

Q

CASNER #1
 NW NW SE SECTION 22-29S-1W
 SEDGWICK COUNTY, KANSAS

I. O. Miller

COMMENCED: JANUARY 29, 1965
 COMPLETED: FEBRUARY 7, 1965

22-29-1W

OPERATOR - I. O. MILLER

DEPTH		FORMATION	REMARKS
FROM	To		
0	30	CLAY	
30	60	SAND	
60	170	CLAY	
170	338	SHALE, SHELLS, LIME	RAN 17 JOINTS 8-5/8" CASING, SET @ 339' w/300 BAGGS CEMENT
338	780	LIME	
780	2770	SHALE & LIME	
2770	2795	SHALE	
2795	3244	LIME	
3244	3355	SHALE & LIME	
3355	3432	LIME	
3432	3525	LIME & CHERT	
3525	3742	LIME	
3742	TD		RAN 116 JOINTS 4 1/2" CASING, SET @ 3731' w/ 135 BAGGS CEMENT

I, E. E. HALL, CERTIFY THIS IS A CORRECT COPY OF THE DRILLER'S LOG FOR THE WELL DRILLED IN THE NW NW SE SECTION 22-29S-1W, SEDGWICK COUNTY, KANSAS, TO THE BEST OF MY KNOWLEDGE AND BELIEF.

E. E. Hall

E. E. HALL

STATE OF KANSAS)
) SS
 COUNTY OF SEDGWICK)

BEFORE ME, THE UNDERSIGNED, A NOTARY PUBLIC WITHIN AND FOR SAID COUNTY AND STATE, ON THIS 11TH DAY OF FEBRUARY, 1965, PERSONALLY APPEARED E. E. HALL, TO ME PERSONALLY KNOWN TO BE THE IDENTICAL PERSON WHO EXECUTED THE WITHIN AND FOREGOING INSTRUMENT AND ACKNOWLEDGED TO ME THAT HE EXECUTED THE SAME AS HIS FREE AND VOLUNTARY ACT AND DEED FOR THE USES AND PURPOSES THEREIN SET FORTH.

IN WITNESS WHEREOF, I HAVE HEREUNTO SET MY HAND AND OFFICIAL SEAL THE DAY AND YEAR LAST ABOVE WRITTEN.

Barbara J. Layton

BARBARA J. LAYTON, NOTARY PUBLIC

MY COMMISSION EXPIRES FEBRUARY 1, 1968

RECEIVED
 STATE CORPORATION COMMISSION

APR 15 1965

CONSERVATION DIVISION
 Wichita, Kansas