


STATE OF KANSAS
STATE CORPORATION COMMISSION

WELL PLUGGING RECORD

Give All Information Completely
Make Required Affidavit
Mail or Deliver Report to
Conservation Division
State Corporation Comm.
245 North Water
Wichita, KS 67202

Steven County, Sec. 20 Twp. 33 Rge. 36 NE/W
Location as "NE/CNW 1/4 SW 1/4" or footage from lines
C-NW 1/4
Lease Owner Northern Pump Co.
Lease Name Carpenter Well No. 1
Office Address Box 937, Garden City, Ks. 67846
Character of Well (Completed as Oil, Gas or Dry Hole)
Gas
Date Well completed 1939
Application for plugging filed 19
Application for plugging approved 3-22-82 19
Plugging commenced 3-22-82 19
Plugging completed 3-23-82 19
Reason for abandonment of well or producing formation
Drilled replacement well
If a producing well is abandoned, date of last production
Nov. 1962

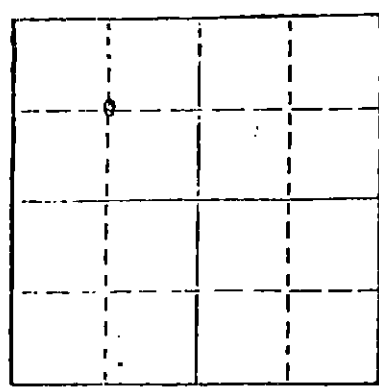

Locate well correctly on above
Section Plat

Name of Conservation Agent who supervised plugging of this well Mr. Thomas
Producing formation Hugoton Depth to top 2845 Bottom 2670 Total Depth of Well 2870
Show depth and thickness of all water, oil and gas formations.

OIL, GAS OR WATER RECORDS

CASING RECORD

FORMATION	CONTENT	FROM	TO	SIZE	PUT IN	PULLED OUT
Surface				10 3/4"	680'	0'
Production				7"	2845	0'

Describe in detail the manner in which the well was plugged, indicating where the mud fluid was placed and the method or methods used in introducing it into the hold. If cement or other plugs were used, state the character of same and depth placed, from _____ feet to _____ feet for each plug set.

Pumped 25 sks. cement to 2600' - Shut in over night
Put bridge & 40 sks. cement 780' to 580'
Displaced w/mud to 60'
Put bridge & 10 sks. 60' to 0'
Cut off 4' below Ground level

RECEIVED
STATE CORPORATION COMMISSION
APR - 9 1982
CONSERVATION DIVISION
Wichita, Kansas

(If additional description is necessary, use BACK of this sheet)

Name of Plugging Contractor Midwest Casing Pulling Service
Permit # 766

STATE OF Kansas COUNTY OF Haskell, ss.
I, Edgar J. Eves (Employer/Owner/Operator)
of the above-described well, being first duly sworn on oath, says: That I have knowledge of the facts, statements, and matters herein contained and the log of the above-described well as filed and that the same are true and correct. So help me God.

(Signature) Edgar J. Eves
Box F, Sublette, Ks. 67877
(Address)

SUBSCRIBED AND SWORN TO before me this 1st day of April, 1982

Sandra L. Eves
Notary Public.

My commission expires 12-6-84



DRILLERS LOG

Well: Carpenter #1

Company: Kuhn Bros.

Locations: C-NW-^{23-36W} 20-30-36

County: Stevens

<u>From</u>	<u>To</u>	<u>Formation</u>
0	264	Sand
264	580	Sand & Blue Clay
580	638	Blue Shale
638	824	Red Bed
824	1156	Shale
1156	1470	Glorietta Sand
1470	2020	Shale
2020	2542	Anhydrite
2542	2785	Shale & Lime

Contractor - Hurreis Drlg. Co.

RECEIVED
STATE CORPORATION COMMISSION

MAR 11 1982

CONSERVATION DIVISION
Wichita, Kansas