

15-189-10061-0000


STATE OF KANSAS
STATE CORPORATION COMMISSION

WELL PLUGGING RECORD

Give All Information Completely
Make Required Affidavit
Mail or Deliver Report to:
Conservation Division
State Corporation Commission
800 Biting Building
Wichita, Kansas

Stevens County, Sec. 25 Twp. 33 Rge. 36 (W) (W)
Location as "NE/CNW/SW" or footage from lines C-NW-SE
Lease Owner Northern Natural Gas Producing Company
Lease Name Nix "A" Well No. 2
Office Address 2223 Dodge Street, Omaha, Nebraska
Character of Well (completed as Oil, Gas or Dry Hole) Dry Hole
Date well completed November 13, 1959
Application for plugging filed November 14, 1959
Application for plugging approved November 14, 1959
Plugging commenced November 14, 1959
Plugging completed November 14, 1959
Reason for abandonment of well or producing formation No productive zone for commercial oil or gas found.
If a producing well is abandoned, date of last production 19
Was permission obtained from the Conservation Division or its agents before plugging was commenced? Yes

NORTH

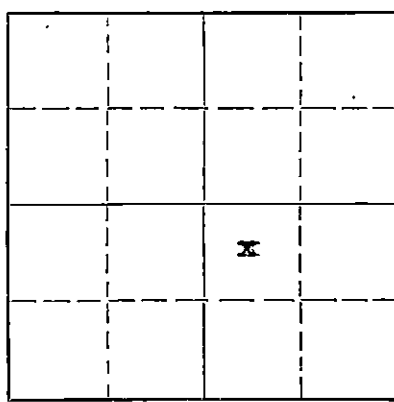

Locate well correctly on above Section Plat

Name of Conservation Agent who supervised plugging of this well Frank Broadfoot
Producing formation _____ Depth to top _____ Bottom _____ Total Depth of Well 6445 Feet
Show depth and thickness of all water, oil and gas formations.

OIL, GAS OR WATER RECORDS

CASING RECORD

FORMATION	CONTENT	FROM	TO	SIZE	PUT IN	PULLED OUT
				8 5/8	1916	

Describe in detail the manner in which the well was plugged, indicating where the mud fluid was placed and the method or methods used in introducing it into the hole. If cement or other plugs were used, state the character of same and depth placed, from _____ feet to _____ feet for each plug set.

Filled hole with heavy mud 6445 to 6200
Spotted 95' ex. Cement 6200 to 5900
Heavy mud from 5900 to 3000
Spotted 130 ex. cement from 3000 to 2600
Heavy mud from 2600 to 1900
Spotted 15 ex. cement at 1900
Heavy mud to 35
Spotted 15 ex. cement from 35 to bottom of cellar and cut 8 5/8 off and welded capon at bottom of cellar.
Halliburton plugs at 1900feet and 35 feet.

RECEIVED
STATE CORPORATION COMMISSION
NOV 18 1959
CONSERVATION DIVISION
Wichita, Kansas

(If additional description is necessary, use BACK of this sheet)

Name of Plugging Contractor D & M Drilling Company, Inc.
Address Box 247, Great Bend, Kansas

STATE OF Kansas, COUNTY OF Stevens, ss.
Richard G. Schmidt (employee of owner) or owner or operator of the above-described well, being first duly sworn on oath, says: That I have knowledge of the facts, statements, and matters herein contained and the log of the above-described well as filed and that the same are true and correct. So help me God.

(Signature) _____
Box 607, Hugoton, Kansas
(Address)

SUBSCRIBED AND SWORN to before me this 16th day of November 1959
Gayle F. Cox
Notary Public.

My commission expires 6-9-62

15-189-10061-0000

NIX 2-A
 C NW/4 SE/4 Sec. 25-33S-36W Stevens Co., Ks.

Rigged up Rotary Tools 9-18-1959

Set 45 jts. 8 5/8"x2 1/4" Casing @1916.12'
 Cemented W/1000 sx Pozmix 2% C.C.

Tore Down Rotary Tools 11-14-59

FORMATION	FROM	TO	
Sand & Gravel	0	565	
Sand & Shale	565	710	
Redbed, Shale & Gyp Stks.	710	1300	
Sand & Shale	1300	1680	
Shale & Shells	1680	1770	
Shale & Lime Stks.	1770	1930	
Shale & Shells	1930	2035	
Shale & Lime Stks.	2035	2360	
Shale & Lime	2360	3573	
Shale & Lime W/Chky. Stkd.	3573	3722	
Lime & Shale	3722	3949	
Lime	3949	4045	
Chalky Lime & Shale	4045	4080	
Lime & Shale	4080	4621	
Lime	4621	4658	
Lime & Shale	4658	4742	
Lime	4742	4821	
Lime W/chert & Shale Stks.	4821	4880	
Lime	4880	5037	
Lime & Shale	5037	5117	
Lime	5117	5365	
Lime & Shale	5365	6073	
Morrow	6073	6091	
Lime & Shale	6091	6445	T. D.

RECEIVED
 STATE CORPORATION COMMISSION

FEB 13 1963

CONSERVATION DIVISION
 Wichita, Kansas