


STATE OF KANSAS  
STATE CORPORATION COMMISSION

Form CP-4

Give All Information Completely  
Make Required Affidavit  
Mail or Deliver Report to:  
Conservation Division  
State Corporation Commission  
212 No. Market  
Wichita, Kansas 67202

WELL PLUGGING RECORD

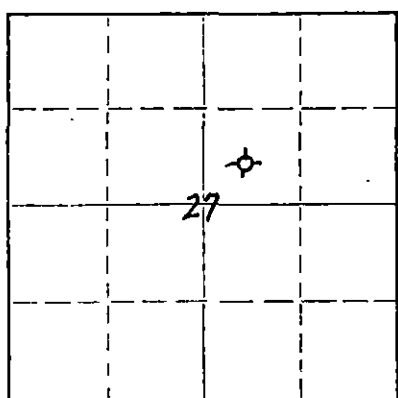

Locate well correctly on above  
Section Plat

STEVENS  
C SW NE County. Sec. 27 Twp. 38S Rge. 36 (X) (W)  
Location as "NE/CNW/SW" or footage from lines. 2310  
Lease Owner. National Oil Co.  
Lease Name. Flower Well No. 1  
Office Address. 200 W. Douglas-Suite 550, Wichita, Ks.  
Character of Well (completed as Oil, Gas or Dry Hole) D&A  
Date well completed Jan. 11, 1972 19  
Application for plugging filed Jan. 11, 1972 19  
Application for plugging approved Jan. 14, 1972 19  
Plugging commenced Jan. 11, 1972 19  
Plugging completed Jan. 11, 1972 19  
Reason for abandonment of well or producing formation no commercial shows of oil  
or gas encountered  
If a producing well is abandoned, date of last production 19  
Was permission obtained from the Conservation Division or its agents before plugging was com-  
menced? yes

Name of Conservation Agent who supervised plugging of this well Edgar J. Eves  
Producing formation \_\_\_\_\_ Depth to top \_\_\_\_\_ Bottom \_\_\_\_\_ Total Depth of Well \_\_\_\_\_ Feet  
Show depth and thickness of all water, oil and gas formations.

OIL, GAS OR WATER RECORDS

CASING RECORD

FORMATION	CONTENT	FROM	TO	SIZE	PUT IN	PULLED OUT
surface hole		surf	1765	8 5/8"	1769	none

Describe in detail the manner in which the well was plugged, indicating where the mud fluid was placed and the method or methods used in introducing it into the hole. If cement or other plugs were used, state the character of same and depth placed, from \_\_\_\_\_ feet to \_\_\_\_\_ feet for each plug set.

Plug @1000' w/35sx  
Plug @ 45' w/15 sx

RECEIVED  
STATE CORPORATION COMMISSION  
FEB 18 1972  
CONSERVATION DIVISION  
Wichita, Kansas

(If additional description is necessary, use BACK of this sheet)  
Name of Plugging Contractor Lohmann-Johnson Drilling Co.  
Address 1701 Fidelity Natl. Bldg. - ~~Wichita, Ks.~~ Okla. City, Okla.

STATE OF Kansas, COUNTY OF Sedgwick, ss.  
Larry L. Taylor (employee of owner) or (owner) of the above-described well, being first duly sworn on oath, says: That I have knowledge of the facts, statements, and matters herein contained and the log of the above-described well as filed and that the same are true and correct. So help me God.

(Signature) Larry L. Taylor  
200 W. Douglas-Suite 550, Wichita, Ks.  
(Address)

Subscribed and Sworn to before me this 17th day of Feb., 19 72  
Jean Stocks  
Jean Stocks Notary Public





STATE OF KANSAS  
DEPARTMENT OF MINES AND MINERALS  
OIL AND GAS DIVISION

RECEIVED  
STATE CORPORATION COMMISSION  
MAR 7 1972  
CONSERVATION DIVISION  
Wichita, Kansas

~~XXXXXXXXXX~~  
XXXXXXXXXX

Permit No. ....

Oil or Gas Well Dry Hole  
(Kind)

**NATIONAL OIL COMPANY**  
Company  
200 W. Douglas, Ste 550, Wichita, Kansas 67202 Casing and Used in Left In Tubing  
Address Drilling Well

Farm FLOWER Acres.....  
Location (waters) C NE - Section 27-33S-36W  
Well No. 1 Elev.....  
District..... County Stevens  
Drilling Commenced 12/22/71  
Drilling Completed 1/10/72  
Name of Contractor LOHMANN-JOHNSON DRILLING CO., INC  
Address of Contractor 1302 Old National Bank Bldg., Evansville, Indiana 47708  
Date Shot..... From..... To.....  
With .....

Open flow /10ths Water in..... Inch  
/10ths Merc. in..... Inch

Size  
16 ..... Kind of Packer  
13 .....  
10 ..... Size of  
8 1/4 8-5/8" set @ 1765' w/750 Sks Cement  
6 3/4 ..... Depth Set.....  
5 3/16 .....  
3 ..... Perf. top.....  
2 ..... Perf. bottom.....  
Perf. top.....  
Perf. bottom.....

Casing Cemented..... Size..... No. Ft..... Date.....

Formation	Color	Hard or Soft	Top	Bottom	Oil, Gas & Coal or Water	Depth Found	Remarks
SURFACE, SHALE & SAND			0	605			
SHALE & SAND			605	1755			
ANHYDRITE			1755	1765			
SHALE & RED BED			1765	2200			
SHALE			2200	2912			
LIME			2912	4227			
LIME & SHALE			4227	4280			
LIME			4280	5448			
SHALE			5448	5507			
LIME & SHALE			5507	5800			
SHALE			5800	5874			
LIME			5874	6160			
SHALE & LIME			6160	6166			
SHALE			6166	6250			
SHALE & LIME			6250	6510			
LIME			6510	6600			
TOTAL DEPTH				6600			

DRY & ABANDONED - Plugged

We, the undersigned, hereby certify that the above is a true and correct Log of the formations encountered in drilling this Well in accordance with the Daily Drilling Reports.

LOHMANN-JOHNSON DRILLING CO., INC  
By Curtis A. Scheible  
Curtis A. Scheible, Vice-President

Subscribed and sworn to before me this 24th day of February, 1972  
Robert L. Freed  
Notary Public

My Commission expires: November 5, 1973