


STATE OF KANSAS
STATE CORPORATION COMMISSION

WELL PLUGGING RECORD

Give All Information Completely
Make Required Affidavit
Mail or Deliver Report to:
Conservation Division
State Corporation Commission
800 Bittling Building
Wichita, Kansas

Stevens County, Sec. 28 Twp. 33 Rge. 36 (X) W (W)
Location as "NE/CNW/SW" or footage from lines Center of NW/4
Lease Owner John B. Hawley, Jr.
Lease Name Carpenter Well No. 2
Office Address Box 94, Great Bend, Kansas
Character of Well (completed as Oil, Gas or Dry Hole) Gas
Date well completed November 1 19 52
Application for plugging filed July 11 19 55
Application for plugging approved July 12 19 55
Plugging commenced July 19 19 55
Plugging completed July 27 19 55
Reason for abandonment of well or producing formation Dry

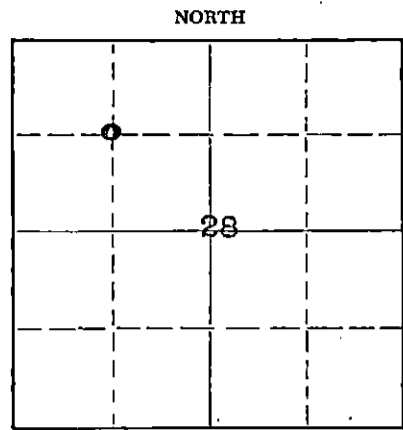

Locate well correctly on above Section Plat

If a producing well is abandoned, date of last production November 19 54
Was permission obtained from the Conservation Division or its agents before plugging was commenced? Yes

Name of Conservation Agent who supervised plugging of this well M. A. Rives
Producing formation Herrington, Winfield & Krider Depth to top Bottom Total Depth of Well 2828 Feet
Show depth and thickness of all water, oil and gas formations.

OIL, GAS OR WATER RECORDS

CASING RECORD

FORMATION	CONTENT	FROM	TO	SIZE	PUT IN	PULLED OUT
				7"	2581'	809'
				10-3/4"	596'	42'

Describe in detail the manner in which the well was plugged, indicating where the mud fluid was placed and the method or methods used in introducing it into the hole. If cement or other plugs were used, state the character of same and depth placed, from _____ feet to _____ feet for each plug set.

Spot 125 sacks on bottom - fillup to 2390' (cement).
Load hole with mud.
Shot pipe at 1754' - 1335' - 1211' - 1009' & 809'.
Pull 809' of 7" pipe.
Spot rock bridge at 550' and 20 sacks cement.
Mud hole - Shot pipe at 275' - 175' - 42'.
Pull 42' of 10-3/4" surface pipe.
Spot rock bridge at 25' and 15 sacks cement.
Hole filled to top of surface.

Attached: Well Log

(If additional description is necessary, use BACK of this sheet)

Name of Plugging Contractor Northern Pump Company
Address Box 94, Great Bend, Kansas

STATE OF Kansas COUNTY OF Barton, ss.
Dale R. Overholt (employee of owner) or (owner or operator) of the above-described well, being first duly sworn on oath, says: That I have knowledge of the facts, statements, and matters herein contained and the log of the above-described well as filed and that the same are true and correct. So help me God.

(Signature) Dale R. Overholt
Box 94, Great Bend, Kansas (Address)

SUBSCRIBED AND SWORN to before me this 1st day of August, 19 55

My commission expires January 28, 1959

Lelandine Turner Notary Public.

PLUGGING
REC 28 T 33 R 36 W
BOOK PAGE 133 LINE 12

RECEIVED
STATE CORPORATION COMMISSION
AUG 2 X 1955
CONSERVATION DIVISION
Wichita, Kansas

John B. Hawley, Jr.
Carpenter #2.
Center of NW/4
Sec. 28-T33S-R36W
Stevens County, Kansas

Elevation: 3032.8'

TOTAL DEPTH: 2828'
Casing: 10-3/4" set at 596'
7" set at 2581'

FROM	TO	FORMATION
0	40	Surface Sand
40	480	Sand and Gravel
480	576	Sand, Shells and Clay
576	580	Sand and Gravel
580	1153	Redbed and Shells
1153	1170	Gyp
1170	1560	Shale and Shells
1560	1585	Broken Anhydrite
1585	1712	Shale and Shells
1712	1735	Anhydrite
1735	1755	Shale and Shells
1755	2300	Anhydrite and Shale Breaks
2300	2390	Shale and Shells
2390	2410	Sticky Shale
2410	2580	Anhydrite
2580	2581	Lime
2581	2594	Anhydrite and Lime Streaks
2594	2625	Broken Lime
2625	2645	Anhydrite and Gray Shale
2645	2660	Gray Lime - Show of gas
2660	2670	Broken Lime
2670	2675	Gray Lime
2675	2700	Hard Sandy Lime - Slight increase in gas 2675-95'
2700	2745	Gray Lime - Small increase in gas 2715-35'
2745	2755	Gray Shale
2755	2770	Gray Lime - Increase in gas 2755-60'
2770	2788	Gray Lime - Increase in gas 2775-88'
2788	2818	Brown Shale
2818	2828	Gray Lime
2828	2828	TOTAL DEPTH

Natural Open Flow: 1,250 MCF
Acidized w/11,000 Gals. - Open Flow 9,446 MCF

PLUGGING
FILE SEC. 28 T. 33 R. 36W
BOOK PAGE 133 LINE 12

RECEIVED
STATE CORPORATION COMMISSION

AUG 21 1955

CONSERVATION DIVISION
Wichita, Kansas