


Give All Information Completely
Make Required Affidavit
Mail or Deliver Report to:
Conservation Division
State Corporation Commission
211 No. Broadway
Wichita, Kansas

WELL PLUGGING RECORD

NORTH

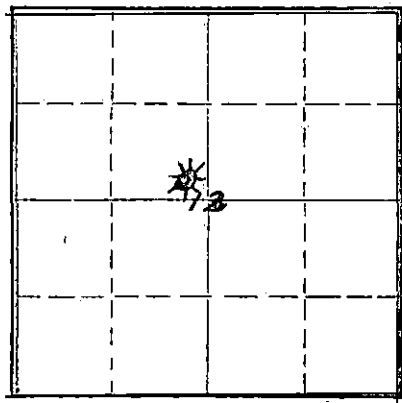

Locate well correctly on above Section Plat

Stevens County, Sec. 12 Twp. 33S Rge. 35W (E) (W)
Location as "NE/CNW'SW" or footage from lines SE/4 SE/4 NW/4
Lease Owner Mobil Oil Corporation
Lease Name Wallace A Well No. 1
Office Address P O Box 1934, OK City, OK
Character of Well (completed as Oil, Gas or Dry Hole) Temporarily abandoned
Date well completed December 5, 1957 19
Application for plugging filed June, 1971 19
Application for plugging approved June, 1971 19
Plugging commenced July 8, 1971 19
Plugging completed July 8, 1971 19
Reason for abandonment of well or producing formation A new well has been drilled to replace the Wallace A No 1
If a producing well is abandoned, date of last production March or April 1967
Was permission obtained from the Conservation Division or its agents before plugging was commenced? Yes

Name of Conservation Agent who supervised plugging of this well E Eaves, Sublette, Kansas
Producing formation Hugoton Series Depth to top 2650 Bottom 2856 Total Depth of Well 2856 Feet
Show depth and thickness of all water, oil and gas formations.

OIL, GAS OR WATER RECORDS

CASING RECORD

FORMATION	CONTENT	FROM	TD	SIZE	PUT IN.	PULLED OUT
				8 5/8 in	550 ft	None
				5 1/2 in	2786 ft	None

Describe in detail the manner in which the well was plugged, indicating where the mud fluid was placed and the method or methods used in introducing it into the hole. If cement or other plugs were used, state the character of same and depth placed, from See below feet to feet for each plug set.

Put 3 cubic yds of river sand in 5 1/2 in csg with 20 bbls of fresh water. Ran steel line measurement. Top of sand in casing at 1637 ft. Ran tbg to 1637 ft depth. Halliburton cemented at 1637 ft with 50 sx common cement. Came up hole with tubing to 619 ft. Set 35 sx plug up from 619 ft. Circulated cement 60 ft to surface. Released Halliburton and J D Well Ser., (Liberal, Kans).

RECEIVED
STATE CORPORATION COMMISSION
AUG 30 1971
CONSERVATION DIVISION
Wichita, Kansas

(If additional description is necessary, use BACK of this sheet)

Name of Plugging Contractor None. Mobil performed abv operations with service co's mentioned.
Address Mobil Oil Corp., P O Box 400, Hugoton, Kans 67951. (JD Littrell, fld rep)

STATE OF Oklahoma COUNTY OF Oklahoma, ss.
Paul K. Langenberg (employee of owner) or owner or operator of the above-described well, being first duly sworn on oath, says: That I have knowledge of the facts, statements, and matters herein contained and the log of the above-described well as filed and that the same are true and correct. So help me God.

(Signature) Paul K. Langenberg
Box 1934 Oklahoma City Oklahoma (Address)

SUBSCRIBED AND SWORN to before me this 27th day of August, 1971

My commission expires 11-17-73

Richard N. Squibb
Notary Public.

15-189-00335-0000
WELL LOG BUREAU—KANSAS GEOLOGICAL SOCIETY
508 East Murdock, Wichita, Kansas


COPY

Company- NORTHERN NATURAL GAS PROD.
Farm- Wallace "A" No. 1

SEC. 12 T. 33 R. 35W
SE SE NW

Total Depth. 2788'
Comm. 12-15-57 Comp. 12-25-57
Shot or Treated.
Contractor. Moran Bros.
Issued. 7-8-61

County Stevens
KANSAS

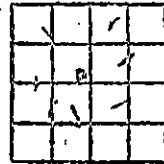

CASING:
8" 622'
5" 2786'

Elevation. 2923'

Production. 2,690,000. CFG

Figures indicate Bottom of Formations.

COMPLETE DRILLERS LOG NOT AVAILABLE:

TOPS: SCOUT
Herington 2622
Upper Krider 2645
Lower Krider 2680
Winfield 2730

Total Depth 2788

RECEIVED
STATE CORPORATION COMMISSION
JUL 1 - 1971
CONSERVATION DIVISION
Wichita, Kansas