

15-189-000(3-0001)
Temporarily Plugged


STATE OF KANSAS
STATE CORPORATION COMMISSION

Form CP-4

Give All Information Completely
Make Required Affidavit
Mail or Deliver Report to:
Conservation Division
State Corporation Commission
212 No. Market
Wichita, Kansas

WELL PLUGGING RECORD

Stevens County. Sec. 17 Twp. 33S Rge. (E) 35 (W)
Location as "NE/CNWxSWx" or footage from lines. CNE $\frac{1}{2}$ SW $\frac{1}{2}$
Lease Owner Shell Oil Company
Lease Name Sandy Well No. 1-17
Office Address 1700 Broadway, Denver, Colorado 80202
Character of Well (completed as Oil, Gas or Dry Hole) D & A
Date well completed May 29, 19 69
Application for plugging filed Yes May 28, 19 69
Application for plugging approved (Verbal) May 28, 19 69
Plugging commenced May 28, 19 69
Plugging completed May 28, 19 69
Reason for abandonment of well or producing formation Dry hole

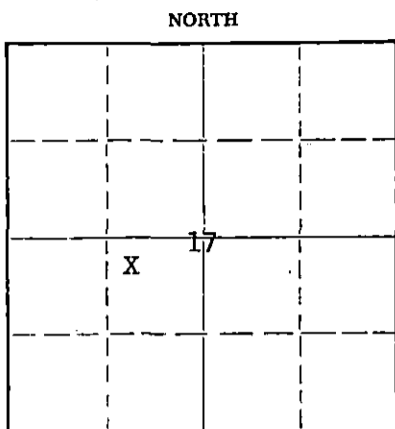

Locate well correctly on above
Section Plat

If a producing well is abandoned, date of last production - 19 -
Was permission obtained from the Conservation Division or its agents before plugging was commenced? Yes

Name of Conservation Agent who supervised plugging of this well Ed Eves Sublette, Kansas
Producing formation Marmaton Depth to top 5024' Bottom _____ Total Depth of Well 5320' Feet
Show depth and thickness of all water, oil and gas formations.

OIL, GAS OR WATER RECORDS

CASING RECORD

FORMATION	CONTENT	FROM	TO	SIZE	PUT IN	PULLED OUT
				<u>4$\frac{1}{2}$"-9.5#</u>	<u>5234'</u>	<u>None</u>

Describe in detail the manner in which the well was plugged, indicating where the mud fluid was placed and the method or methods used in introducing it into the hole. If cement or other plugs were used, state the character of same and depth placed, from _____ feet to _____ feet for each plug set.

Released retrievable pkr. Pulled tbg. and pkr. Ran 4 $\frac{1}{2}$ " cast iron permanent bridge plug and set w/wire line at 4900'. Filled hole w/fresh water. Pumped 1 $\frac{1}{2}$ sxs cmt on top of plug w/dump bailer. Cut off csg and welded on steel plate.

Temporarily Plugged

RECEIVED
STATE CORPORATION COMMISSION
JUN 10 1969
CONSERVATION DIVISION
Wichita, Kansas

(If additional description is necessary, use BACK of this sheet)
Name of Plugging Contractor Shell Oil Company
Address 1700 Broadway, Denver, Colorado 80202

STATE OF COLORADO, COUNTY OF DENVER, ss.
W. M. Koch (employee of owner) or (owner or operator) of the above-described well, being first duly sworn on oath, says: That I have knowledge of the facts, statements, and matters herein contained and the log of the above-described well as filed and that the same are true and correct. So help me God.
(Signature) W. M. Koch Div. Prod. Supt.
1700 Broadway, Denver, Colo. - Okla. Div.
(Address)

SUBSCRIBED AND SWORN TO before me this 6 day of June, 19 69

My commission expires July 1, 1969

J. Louis Pelcher
Notary Public.

SHELL-SANDY Area 9 No. 1-17
C NE SW Section 17-33S-35W
Wildcat (Hugoton)
Stevens County, Kansas

Casing Record

8 5/8" cem 665 with 475 sax

RECEIVED
STATE CORPORATION COMMISSION
JUN 3 1969
CONSERVATION DIVISION
Wichita, Kansas

- 0 - 532 surface
- 670 sand & red bed
- 1120 red beds & anhydrite
- 1826 shale & anhydrite
- 1830 shale
- 2352 shale, lime & salt
- 2503 shale & lime
- 2620 shale, anhydrite & lime
- 2907 shale & lime
- 2995 lime & anhydrite
- 3166 lime
- 3411 lime & shale
- 4100 lime
- 4233 lime & shale
- 4271 lime
- 4410 lime & shale
- 4669 lime
- 4725 shale
- 4805 shale & lime
- 4933 lime
- 5014 lime & shale
- 5261 lime
- 5289 lime & shale
- 5362 lime
- 5423 lime & shale
- 5463 shale
- 5551 shale & lime
- 5683 shale
- 5789 lime & shale
- 5858 shale
- 5933 lime & shale
- 5990 shale & sand
- 6001 sand
- 3076 shale & sand
- 6189 shale
- 6309 shale & lime
- 6335 lime T.D.

STATE OF KANSAS)
) SS
County of Barton)

I hereby affirm that the above and foregoing is a true and correct copy of the drillers' log of the Sandy Area 9 No. 1-17 well, located in Section 17-33S-35W, Stevens County, Kansas.

Shell Oil Company

By *[Signature]*
Superintendent

Subscribed and sworn to before me a Notary Public this 14th day of October, 1959.

[Signature]
Notary Public

My commission expires: January 28, 1961.

- Log tops:
- Winfield 2730
 - Council Grove 3024
 - Neva 3166
 - Virgil 3459
 - Topeka 3844
 - Toronto 4214
 - Lansing-Kansas City 4315
 - Marmaton 5024
 - Cherokee 5334
 - Morrow Shale 3700
 - Morrow Sand 5988-6000
 - Chester 6080
 - Chester Sand 6228-6242
 - St. Genevieve 6285