


Give All Information Completely  
Make Required Affidavit  
Mail or Deliver Report to:  
Conservation Division  
State Corporation Commission  
211 No. Broadway  
Wichita, Kansas

WELL PLUGGING RECORD

15-189-00012-0000

NORTH

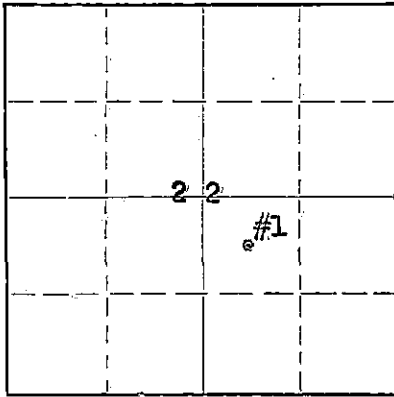

Locate well correctly on above Section Plat

Stevens

County, Sec. 22 Twp. 33S Rge. 35W (E) (W)  
Location as "NE/CNW&SW" or footage from lines 560' W line & 1980' F/S Line SE/4  
Lease Owner Sinclair Oil & Gas Company  
Lease Name H. A. Kinney Well No. 1  
Office Address P. O. Box 521, Tulsa, Oklahoma  
Character of Well (completed as Oil, Gas or Dry Hole) Dry Hole  
Date well completed June 18th 19 59  
Application for plugging filed June 18th 19 59  
Application for plugging approved (Verbal, by M. A. Rives) 6-17 19 59  
Plugging commenced June 18th 19 59  
Plugging completed 4:PM June 18th 19 59  
Reason for abandonment of well or producing formation Dry Hole - Non Commercial

If a producing well is abandoned, date of last production \_\_\_\_\_ 19\_\_\_\_  
Was permission obtained from the Conservation Division or its agents before plugging was commenced? Yes

Name of Conservation Agent who supervised plugging of this well Mr. M. A. Rives  
Producing formation None Depth to top \_\_\_\_\_ Bottom \_\_\_\_\_ Total Depth of Well 6480 Feet  
Show depth and thickness of all water, oil and gas formations.

OIL, GAS OR WATER RECORDS

CASING RECORD

FORMATION	CONTENT	FROM	TO	SIZE	PUT IN	PULLED OUT
<u>None encountered</u>						

Describe in detail the manner in which the well was plugged, indicating where the mud fluid was placed and the method or methods used in introducing it into the hole. If cement or other plugs were used, state the character of same and depth placed, from \_\_\_\_\_ feet to \_\_\_\_\_ feet for each plug set.

Plugged from total depth 6480' to 700' with heavy drilling mud. 20 sacks cement spotted at 700', from top of plug at 700' to 30' with heavy drilling mud, from 30' to surface with 20 sacks cement.

RECEIVED  
STAT. COMMISSION  
JUN 24 1959  
CONSERVATION DIVISION  
Wichita, Kansas

(If additional description is necessary, use BACK of this sheet)

Name of Plugging Contractor Earl Wakefield  
Address 515 Union Center Bldg., Wichita, Kansas

STATE OF Kansas, COUNTY OF Rice, ss.  
I, C. B. York (employee of owner) or (owner or operator) of the above-described

well, being first duly sworn on oath, says: That I have knowledge of the facts, statements, and matters herein contained and the log of the above-described well as filed and that the same are true and correct. So help me God.

(Signature) C. B. York  
P. O. Box 466, Chase, Kansas  
(Address)

SUBSCRIBED AND SWORN TO before me this 23 day of June, 19 59

L. B. Reynolds  
L. B. Reynolds Notary Public.

My commission expires August 13, 1962

PLUGGING  
FILE SEC. 22 TWP. 33 R. 35W  
BOOK PAGE 46 LINE 38

LEASE: H. A. KINNEY #1  
 OPERATOR: SINCLAIR OIL & GAS CO.  
 CONTRACTOR: EARL F. WAKEFIELD  
 COMM: 5/14/59 COMP: 6/18/59

LOCATION: C NW SE  
 SECTION 22-33S-35W  
 STEVENS COUNTY, KANSAS  
 CASING: 13 3/8" Set @ 729 Feet  
 8 5/8" Set @ 2840 Feet

ELEVATION 2971 G.L.  
 2981 K.B.

Sand and Clay	470
Water Sand and Gravel	655
Red Shale	730
Red Bed	1264
Red Bed and Sand	1500
Shale and Shells	1715
Anhydrite	1973
Shale and Gyp	2128
Red and Blue Shale streaks Anhydrite	2232
Lime and Shale	2421
Lime	3194
Red Shale with Streaks Lime	3227
Lime	3363
Lime and Shale	3432
Lime	3615
Chalky Lime	3750
Lime	3779
Chalky Lime	3934
Lime and Shale	4039
Lime	4088
Lime and Shale	4123
Lime	4487
Chalky Lime	4598
Lime with streaks of chalk	4664
Lime	4791
Lime and Shale	4836
Lime	5421
Lime and Shale	5465
Shale and Lime	5543
Shale and Shells	5664
Shale and Lime	5725
Shale	5805
Black Shale	5882
Shale	5990
Shale and Lime	6026
Shale and Sand	6050
Lime	6115
Lime and Shale	6210
Shale and Lime	6310
Lime	6480
T.D.	6480

RECEIVED  
 STATE COMMISSION

JUL 16 1959

CONSERVATION DIVISION

STATE OF KANSAS )  
 ) ss  
 COUNTY OF SEDGWICK)

I hereby certify that the above is a true and correct copy of the log on the H. A. Kinney #1 Well, located C NW SE Section 22-33S-35W, Stevens County, Kansas.

EARL F. WAKEFIELD

By Earl F. Wakefield

Subscribed and sworn before me this 26th day of June, 1959.

C. A. Snow  
 C. A. Snow Notary Public

My Commission expires July 26, 1962.

PLUGGING  
 FILE SEC. 22 T28 R2W  
 BOOK PAGE 46 LINE 38