


WELL PLUGGING RECORD

Give All Information Completely  
Make Required Affidavit  
Mail or Deliver Report to:  
Conservation Division  
State Corporation Commission  
212 North Market, Insurance Bldg.  
Wichita, Kansas

Stevens County, Sec. 27 Twp. 33S Rge. (E) 35 (W)  
Location as "NE/CNW/SW" or footage from lines 1984 FN & WL SE/NW  
Lease Owner Northern Natural Gas Producing Company  
Lease Name Hilbig A Well No. 1  
Office Address 610 Union Center Building, Wichita, Kansas  
Character of Well (completed as Oil, Gas or Dry Hole) Gas  
Date well completed April 26 1957  
Application for plugging filed May 1, 1960  
Application for plugging approved May 26 1960  
Plugging commenced June 4, 1960  
Plugging completed June 7, 1960  
Reason for abandonment of well or producing formation Casing Failure

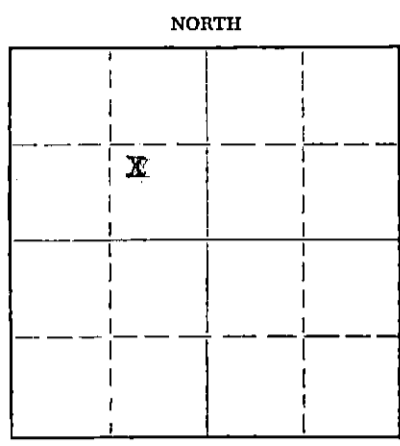

Locate well correctly on above Section Plat

If a producing well is abandoned, date of last production N.A. 19      
Was permission obtained from the Conservation Division or its agents before plugging was commenced? Yes

Name of Conservation Agent who supervised plugging of this well \_\_\_\_\_  
Producing formation Krider & Winfield Depth to top 2704 Bottom 2808 Total Depth of Well 2860 Feet  
Show depth and thickness of all water, oil and gas formations.

OIL, GAS OR WATER RECORDS

CASING RECORD

FORMATION	CONTENT	FROM	TO	SIZE	PUT IN	PULLED OUT
Hollenberg	-	2630	2680	8 5/8"	543'	
Herington	-	2680	2745	5 1/2"	2843'	
Lower Krider	Gas	2745	2795			
Winfield	Gas	2795	2845			
Upper Fort Riley	-	2845	2860			

Describe in detail the manner in which the well was plugged, indicating where the mud fluid was placed and the method or methods used in introducing it into the hole. If cement or other plugs were used, state the character of same and depth placed, from \_\_\_\_\_ feet to \_\_\_\_\_ feet for each plug set.

Shot 2-1/2" EUE tubing @ 1,826 ft. - Mix, pump & spot 30 sacks common cement at that point, displacing same with 15 bbls. of mud laden fluid & complete recovery of 2-1/2" tubing.  
Shot 5-1/2" casing @ 626 ft. & spot 30 sacks common cement from 624 ft. to 515 ft. - Complete recovery of 5-1/2" casing. - Load 8-5/8" surface pipe with mud laden fluid to within 30 ft. of top of surface, filling remainder with 10 sacks common cement for plug & cap on top.

RECEIVED  
STATE CORPORATION COMMISSION  
SEP 23 1960  
CONSERVATION DIVISION  
Wichita, Kansas

(If additional description is necessary, use BACK of this sheet)  
Name of Plugging Contractor DACO LEASE & WELL SERVICE  
Address 1700 S. MAIN ST. BORGER, TEXAS

STATE OF Kansas, COUNTY OF Sedgwick, ss.  
Donald L. Horton (employee of owner) or (owner or operator) of the above-described well, being first duly sworn on oath, says: That I have knowledge of the facts, statements, and matters herein contained and the log of the above-described well as filed and that the same are true and correct. So help me God.  
(Signature) Donald L. Horton  
610 Union Center Building, Wichita, Kansas  
(Address)

SUBSCRIBED AND SWORN TO before me this 30th day of June, 1960  
Barbara A. Baughman  
Notary Public.

My commission expires January 14, 1964



## NORTHERN NATURAL GAS PRODUCING COMPANY

HILBIG "A" WELL NO. 1  
WELL LOGRECEIVED  
STATE CORPORATION COMMISSION

SEP 28 1960

CONSERVATION DIVISION  
Wichita, KansasLocation: C SE/4 NW/4 Sec. 27-33S-35W  
Stevens County, Kansas

Commenced: 2-14-57

Completed: 4-26-57 As a Gas Well

## Casing Record:

Surface - 543' of 8 5/8" with 375 sx. cement  
Production - 2843' of 5 1/2" with 475 sx. cement

## Formation Record:

<u>Formation</u>	<u>Depth</u>
Hollenberg	2630'
Herington	2680'
Lower Krider	2745'
Winfield	2795'
Upper Fort Riley	2845'
Total Depth	2860'

I hereby certify that this is a true and correct well log  
of this well from the available information to the best of my  
knowledge.

Northern Natural Gas Producing Company

Donald L. Horton  
Donald L. Horton

Subscribed and sworn to before me this 30 day of June, 1960.

Barbara A. Gaughan  
Barbara A. Gaughan, Notary Public

My Commission Expires January 14, 1964