


STATE OF KANSAS
STATE CORPORATION COMMISSION

WELL PLUGGING RECORD

Give All Information Completely
Make Required Affidavit
Mail or Deliver Report to:
Conservation Division
State Corporation Commission
212 North Market, Insurance Bldg.
Wichita, Kansas

NORTH

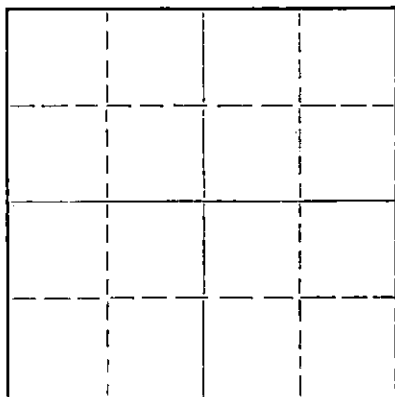

Locate well correctly on above
Section Plat

Sumner County. Sec. 34 Twp. 30S Rge. 3 (E) (W)
Location as "NE/CNW/SW" or footage from lines NE NE SW
Lease Owner Shawver-Armour, Inc.
Lease Name Jenkins Well No. 1
Office Address 817 Central Building
Character of Well (completed as Oil, Gas or Dry Hole) Dry hole
Date well completed November 19 19 59
Application for plugging filed November 19 19 59
Application for plugging approved November 19 19 59
Plugging commenced November 19 19 59
Plugging completed November 19 19 59
Reason for abandonment of well or producing formation Dry hole

If a producing well is abandoned, date of last production 19
Was permission obtained from the Conservation Division or its agents before plugging was commenced? Yes

Name of Conservation Agent who supervised plugging of this well Lee N. Guthrie
Producing formation 230 Depth to top Bottom Total Depth of Well 4312 Feet
Show depth and thickness of all water, oil and gas formations.

OIL, GAS OR WATER RECORDS

CASING RECORD

FORMATION	CONTENT	FROM	TO	SIZE	PUT IN	PULLED OUT
Surface	Water	0	150'	8 5/8"	150'	None

Describe in detail the manner in which the well was plugged, indicating where the mud fluid was placed and the method or methods used in introducing it into the hole. If cement or other plugs were used, state the character of same and depth placed, from feet to feet for each plug set.

#1 Plug @ 230
1/2 sx hulls 15 sx cement
Heavy mud to 30' #2 Plug
8 sx cement

RECEIVED
STATE CORPORATION COMMISSION
12-4-59
DEC 4 1959

CONSERVATION DIVISION

(If additional description is necessary, use BACK of this sheet)

Name of Plugging Contractor Shawver-Armour, Inc.
Address 817 Central Building, Wichita, Kansas

STATE OF Kansas, COUNTY OF Sedgwick, ss.
James M. Armour (employee of owner) or (owner or operator) of the above-described well, being first duly sworn on oath, says: That I have knowledge of the facts, statements, and matters herein contained and the log of the above-described well as filed and that the same are true and correct. So help me God.

(Signature) James M. Armour
JAMES M. ARMOUR 817 Central Building
(Address)

SUBSCRIBED AND SWORN TO before me this 19th day of November, 19 59

Marjorie Hall

My commission expires December 29, 1959

MARJORIE HALL

Notary Public.



DRILLER'S LOG

FARM NAME: JENKINS LOCATION: NE NE SW SEC. 34-30S-3W
 CONTRACTOR: SHAWVER ARMOUR, INC. SUMNER County, Kansas
 ELEVATION: 1333 K. B.
 OWNER: SHAWVER ARMOUR, INC.
 COMMENCED: NOVEMBER 9, 1959 COMPLETED: November 19, 1959
 CASING RECORD: 223' G.G. w/135 sx cement
 2% CC

FORMATION:

TOPS:

Soil	4
Red Clay	30
Red Shale & Shells	223
Anhydrite & Blue Shale	580
Anhydrite & Shale	1100
Lime & Shale	3237
Kansas City Lime	3472
Lime & Shale	3851
Mississippian Lime & Chert	3907
Mississippian Lime	3960
Lime	4132
Mississippian Lime	4212
Lime & Shale	4302
Simpson Sand	4307
Simpson	4312 TD D&A

Kansas City	3227
Mississippian	3851
Simpson	4285

RECEIVED
 STATE CORPORATION COMMISSION
 DEC 4 1959
 CONSERVATION DIVISION
 Wichita, Kansas

STATE OF KANSAS)
) SS
 SEDGWICK COUNTY)

I, James M. Armour, do hereby certify that the above log is a true and correct copy of the above captioned well as shown on the daily drilling reports.

SHAWVER-ARMOUR, INC.

BY James M. Armour

JAMES M. ARMOUR

Subscribed and sworn to before me this
 1st day of December, 1959

My commission expires December 29th, 1959

Marjorie Hall
 MARJORIE HALL, NOTARY PUBLIC