

WELL PLUGGING RECORD

Give All Information Completely
Make Required Affidavit
Mail or Deliver Report to:
Conservation Division
State Corporation Commission
211 No. Broadway
Wichita, Kansas

Morton County, Sec. 4 Twp. 33S Rge. (E) 41 (W)

Location as "NE/CNW/SW" or footage from lines Ctr SE SE

Lease Owner CitiesService Oil Company

Lease Name Heyen "B" Well No. 1

Office Address Box 1028, Guymon, Oklahoma

Character of Well (completed as Oil, Gas or Dry Hole) Dry Hole

Date well completed 3-5 1964

Application for plugging filed 3-5 1964

Application for plugging approved 3-6 1964


Plugging commenced 3-8 1964

Plugging completed 3-8 1964

Reason for abandonment of well or producing formation Dry Hole

If a producing well is abandoned, date of last production 19

Was permission obtained from the Conservation Division or its agents before plugging was commenced? Yes

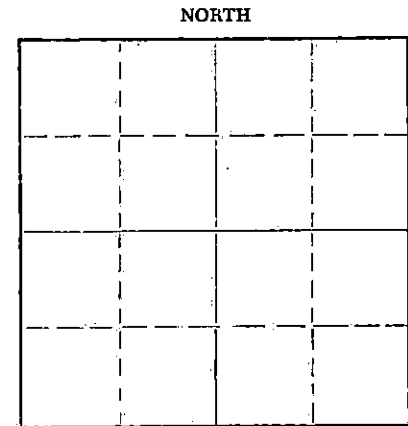

Locate well correctly on above Section Plat

Name of Conservation Agent who supervised plugging of this well Hugh Scott

Producing formation Depth to top Bottom Total Depth of Well Feet

Show depth and thickness of all water, oil and gas formations.

OIL, GAS OR WATER RECORDS

CASING RECORD

FORMATION	CONTENT	FROM	TO	SIZE	PUT IN	PULLED OUT
Upper Morrow	Dry	5048	5065	8 5/8"	1501	None
Winfield	Dry	2238	2260	4 1/2"	5099	3005'
Krider	Dry	2200	2216	5 1/2"	2400	1599'

Describe in detail the manner in which the well was plugged, indicating where the mud fluid was placed and the method or methods used in introducing it into the hole. If cement or other plugs were used, state the character of same and depth placed, from feet to feet for each plug set.

Squeezed perforations @5042' w/75 sacks of common cement, shot off 4 1/2" casing at 3100' pulled 3006'. Ran 2400' of 5 1/2" casing. Spotted 50 sacks of common cement at 1796', shot 5 1/2" casing at 1600' pulled 1599' of 5 1/2" casing. Spotted 35 sacks of common cement from 600' to 700' and 15 sacks of common cement from 45' to 5' of ground level at which point the 8 5/8" casing was cut off and a steel cap welded on.

RECEIVED
STATE CORPORATION COMMISSION

MAR 11 1964

CONSERVATION DIVISION
Wichita, Kansas

(If additional description is necessary, use BACK of this sheet)

Name of Plugging Contractor DACO Lease and Well Service

Address Borger, Texas

STATE OF Oklahoma, COUNTY OF Texas, ss.

I, H. E. Massey (employee of owner) or (owner or operator) of the above-described well, being first duly sworn on oath, says: That I have knowledge of the facts, statements, and matters herein contained and the log of the above-described well as filed and that the same are true and correct. So help me God.

(Signature) H. E. Massey H E Massey

Dist. Supt. Guymon, Oklahoma Box 1028 (Address)

SUBSCRIBED AND SWORN TO before me this 10th day of March, 1964

Gloyd L. Shockley Gloyd L. Shockley Notary Public.

My commission expires 5-4-66

