

STATE OF KANSAS
STATE CORPORATION COMMISSION

WELL PLUGGING RECORD


Give All Information Completely
Make Required Affidavit
Mail or Deliver Report to
Conservation Division
State Corporation Comm.
245 North Water
Wichita, KS 67202

County. Sec. 36 Twp. 30 Rge. 3w E/W
Location as "NE/CNW $\frac{1}{4}$ SW $\frac{1}{4}$ " or footage from lines
SE/NE/NE

Lease Owner Hummon Oil CO.
Lease Name Hare Well No. 1

Office Address 1725 Vickers/ KSB&T Bldg. Wichita 67202
Character of Well (Completed as Oil, Gas or Dry Hole)

Dry Hole
Date Well completed 19
Application for plugging filed 19
Application for plugging approved 19
Plugging commenced 4-18-79 19
Plugging completed 4-27-79 19
Reason for abandonment of well or producing formation

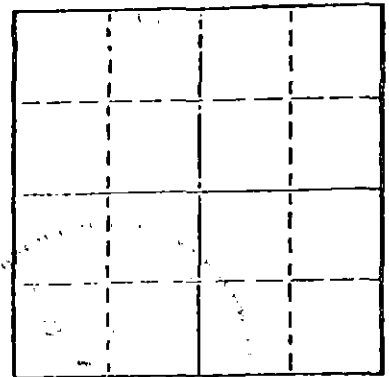

If a producing well is abandoned, date of last production 19

Was permission obtained from the Conservation Division or its agents before plugging was commenced? yes

Name of Conservation Agent who supervised plugging of this well Carl Barnett
Producing formation Depth to top Bottom Total Depth of Well 2960
Show depth and thickness of all water, oil and gas formations.

OIL, GAS OR WATER RECORDS

CASING RECORD

FORMATION	CONTENT	FROM	TO	SIZE	PUT IN	PULLED OUT
		Surface		8 5/8"	244'	none
		Oil string		4 1/2"	2046'	2375'

Describe in detail the manner in which the well was plugged, indicating where the mud fluid was placed and the method or methods used in introducing it into the hold. If cement or other plugs were used, state the character of same and depth placed, from feet to feet for each plug set.

Sanded Bottom of hole from 2960' to 2880' set four sks. cement with bailer
Recovered 2375' of 4 1/2" casing set rock bridge at 250'
Filled with ready mix to base of celler used 4 yds. ready mix

RECEIVED
STATE CORPORATION COMMISSION

MAY - 2 1979


(If additional description is necessary, use BACK of this sheet)
Name of Plugging Contractor Voth casing pulling CONSERVATION DIVISION
Wichita, Kansas

STATE OF Kansas COUNTY OF Cowley, ss.
Walter Voth (employee of owner) or (owner or operator)
of the above-described well, being first duly sworn on oath, says: That I have knowledge of the facts, statements, and matters herein contained and the log of the above-described well as filed and that the same are true and correct. So help me God.

(Signature) Walter Voth
715 South A Arkansas City Ks. 67005
(Address)

SUBSCRIBED AND SWORN TO before me this 1 day of May 19 79

My commission expires June 1, 1981
Gyonne Duncan
Notary Public.

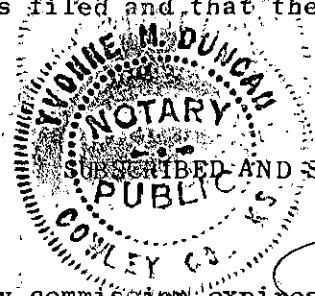

GABBERT-JONES, INC.
WICHITA, KANSAS
DRILLERS' WELL LOG

RECEIVED
STATE CORPORATION COMMISSION

JAN 22 1979

CONSERVATION DIVISION
Wichita, Kansas

Well #1
SE-NE-NE Sec 25-30S-3W
Sumner County Kansas

Commenced: 7-27-78

Completed: 8-2-78

OPERATOR: HURMON OIL CO.

Depth		Formation	Remarks
From	To		
0	180	Surface Clay-Redbed	Ran 6 jts of 8 5/8" csg sat @ 244' Cemented w/200 sks Common 2% Gel 3% CC PD @ 4:30 P.M. 7-27-78
180	1245	Shale-Shells	
1245	1580	Lime-Shale	
1580	1885	Shale-Lime	
1885	2585	Lime-Shale	
2585	2843	Shale-Lime	Ran 71 jts of 10 1/2" 4 1/2" csg sat @ 2948' Cemented w/100 sks 60/40 Posmix 18% Salt PD @ 4:00 p.m. 8-2-78
2843	2900	Sand	
2900	2960	Sand-Shale	
	2960 - TD		

STATE OF KANSAS)
) SS
COUNTY OF SEDGWICK)

I, the undersigned, being duly sworn on oath, state that the above Drillers' Well Log is true and correct to the best of my knowledge and belief and according to the records of this office.

GABBERT-JONES, INC.

James S. Sutton II
JAMES S. SUTTON II

Subscribed and sworn to before me this 10th day of August, 1978.

Elizabeth J. Edwards
ELIZABETH J. EDWARDS-NOTARY PUBLIC

My Commission expires February 6, 1979.

