


STATE OF KANSAS
STATE CORPORATION COMMISSION

WELL PLUGGING RECORD

Give All Information Completely
Make Required Affidavit
Mail or Deliver Report to:
Conservation Division
State Corporation Commission
212 North Market, Insurance Bldg.
Wichita, Kansas

NORTH

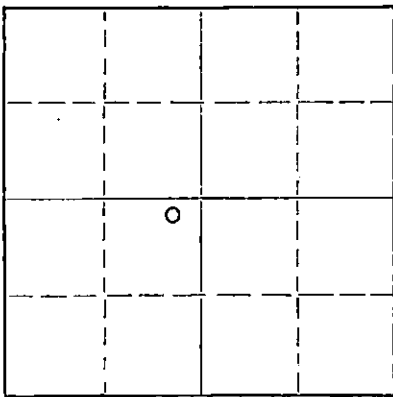

Locate well correctly on above
Section Plat

Sumner County. Sec. 35 Twp. 30S Rge. 3 ~~EX~~ (W)
Location as "NE/CNW/SW" or footage from lines NE/4 NE/4 SW/4
Lease Owner Twin Drilling, Inc.
Lease Name Hunt Well No. 1
Office Address 1005 Central Bldg., Wichita, Kansas
Character of Well (completed as Oil, Gas or Dry Hole) Dry
Date well completed 7-25 19 60
Application for plugging filed 7-25 19 60
Application for plugging approved 7-25 19 60
Plugging commenced 7-25 19 60
Plugging completed 7-25 19 60
Reason for abandonment of well or producing formation Dry

If a producing well is abandoned, date of last production 19
Was permission obtained from the Conservation Division or its agents before plugging was commenced? Yes

Name of Conservation Agent who supervised plugging of this well Eugene H. Graham, Winfield, Kansas
Producing formation Depth to top Bottom Total Depth of Well 4233 Feet
Show depth and thickness of all water, oil and gas formations.

OIL, GAS OR WATER RECORDS

CASING RECORD

FORMATION	CONTENT	FROM	TO	SIZE	PUT IN	PULLED OUT
				8 5/8	208.45	-

Describe in detail the manner in which the well was plugged, indicating where the mud fluid was placed and the method or methods used in introducing it into the hole. If cement or other plugs were used, state the character of same and depth placed, from feet to feet for each plug set.

Filled hole up to 200' with mud.
Set plug on mud with hulls & 15 sacks cement
Filled up to 35' of base of cellar
Set plug with hulls & 10 sacks cement.

RECEIVED
STATE CORPORATION COMMISSION
AUG 1 1960
CONSERVATION DIVISION
WICHITA, KANSAS

(If additional description is necessary, use BACK of this sheet)
Name of Plugging Contractor Twin Drilling, Inc.
Address 1005 Central Bldg., Wichita, Kansas

STATE OF Kansas, COUNTY OF Sedgwick, ss.
C. R. Dunne (employee of owner) or (owner or operator) of the above-described well, being first duly sworn on oath, says: That I have knowledge of the facts, statements, and matters herein contained and the log of the above-described well as filed and that the same are true and correct. So help me God.

(Signature) *C. R. Dunne*
Wichita, Kansas
(Address)

SUBSCRIBED AND SWORN TO before me this 29 day of July, 19 60

Almeda Day
(Signature)

Notary Public.

My commission expires 9-9-61

WELL LOG

Operator: Twin Drilling, Inc.
1005 Central Building
Wichita, Kansas

Well: Hunt #1

Location: NE/4 NE/4 SW/4
Sec. 35-30S-3W
Sumner Co., Kansas.

Contractor: Same

Elevation: 1312' R.B.

Commenced: 7-14-60

Completed: 7-25-60

Casing: 208.45' 8 5/8" Surface
w/ 125 Sax

Sand	45
Shale & Shells	550
Lime & Shale	1235
Shale & Lime Streaks	1430
Shale & Lime	2220
Lime & Shale Streaks	2270
Shale & Lime Shells	2565
Shale & Lime	2935
Lime Shells & Shale	3125
Lime & Shale	3175
Lime	3450
Shale & Lime	3805
Lime	4163
Shale	4190
Sand	4233

TOPS

Iotan	2887
Stalnaker	2986
Kansas City	3173
Marmaton	3460
Cherokee	3619
Mississippi	3823
Kinderhook	4162
Simpson	4229

T.D. 4233'

STATE OF KANSAS }
COUNTY OF SEDGWICK } SS.

The undersigned, TWIN DRILLING, INC., hereby certifies that the above log is a true and correct log of the formations encountered in drilling the above well as reflected by the Daily Drilling Report.

TWIN DRILLING, INC.

By Almaida Day

Subscribed and sworn to before me
this 29th day of July, 1960.

James A. Hicks
Notary Public

My commission expires
September 29, 1960.

RECEIVED
STATE CORPORATION COMMISSION
AUG 1 1960
CONSERVATION DIVISION
Wichita, Kansas