


Give All Information Completely
Make Required Affidavit
Mail or Deliver Report to:
Conservation Division
State Corporation Commission
211 No. Broadway
Wichita, Kansas

WELL PLUGGING RECORD

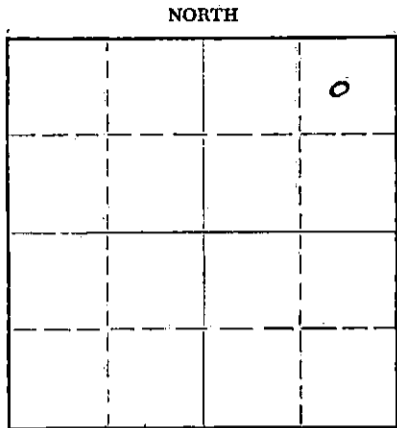

Locate well correctly on above Section Plat

Seward County. Sec. 12 Twp. 33S Rge. 34 (E) (W)
Location as "NE/CNW*SW*" or footage from lines C NE NE
Lease Owner Falcon Seaboard Drilling Company
Lease Name Katie M. Lee Well No. 1
Office Address 118 West 6th Street
Character of Well (completed as Oil, Gas or Dry Hole) Dry Hole
Date well completed June 27 19 64
Application for plugging filed June 27 19 64
Application for plugging approved June 27 19 64
Plugging commenced June 27 19 64
Plugging completed June 27 19 64
Reason for abandonment of well or producing formation Dry

If a producing well is abandoned, date of last production 19
Was permission obtained from the Conservation Division or its agents before plugging was commenced? Yes

Name of Conservation Agent who supervised plugging of this well Hugh E. Scott
Producing formation Depth to top Bottom Total Depth of Well 6425 Feet
Show depth and thickness of all water, oil and gas formations.

OIL, GAS OR WATER RECORDS

CASING RECORD

FORMATION	CONTENT	FROM	TO	SIZE	PUT IN	PULLED OUT
				8-5/8"	1620'	None

Describe in detail the manner in which the well was plugged, indicating where the mud fluid was placed and the method or methods used in introducing it into the hole. If cement or other plugs were used, state the character of same and depth placed, from feet to feet for each plug set.

Hole was full of mud. Set 35-sack cement plug @ 700', and 15-sacks cement in top of 8-5/8" casing. Weld steel plate on top of 8-5/8" casing.

RECEIVED
STATE CORPORATION COMMISSION

JUN 30 1964

CONSERVATION DIVISION
Wichita, Kansas

(If additional description is necessary, use BACK of this sheet)
Name of Plugging Contractor Halliburton Company and D & M Drilling Company, Inc.
Address Wichita, Kansas.

STATE OF OKLAHOMA, COUNTY OF TULSA, ss.
J. O. Brown (employee of owner) or (owner or operator) of the above-described well, being first duly sworn on oath, says: That I have knowledge of the facts, statements, and matters herein contained and the log of the above-described well as filed and that the same are true and correct. So help me God.

(Signature) *J. O. Brown*
118 West 6th Street, Tulsa, Oklahoma
(Address)

SUBSCRIBED AND SWORN TO before me this 29th day of June, 19 64

My commission expires April 6, 1967

Therese Donohoo
Notary Public.