15-175-00177-0001

STATE OF KANSAS
STATE CORPORATION COMMISSION

Give All Information Completely
Make Required Affidavit
Mail or Deliver Report to:
Conservation Division
State Corporation Commission
211 No. Broadway
Wichita, Kansas

Form CP-4

WELL PLUGGING RECORD

NORTH

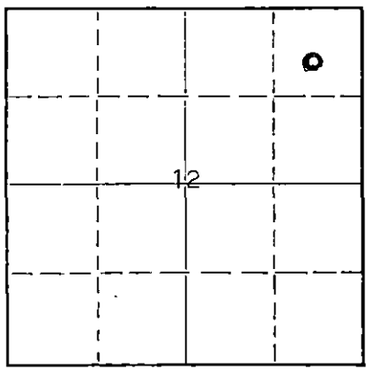

Locate well correctly on above Section Plat

SEWARD County. Sec. 12 Twp. 33S Rge. 34 (E) (W)

Location as "NE/CNW¼SW¼" or footage from lines C NE/4 OF NE/4

Lease Owner DAVIDOR & DAVIDOR, INC.

Lease Name KATIE LEE Well No. 1

Office Address 4515 N. SANTA FE, OKLAHOMA CITY, OKLAHOMA

Character of Well (completed as Oil, Gas or Dry Hole) DRY HOLE

Date well completed OCTOBER 12 19 67

Application for plugging filed OCTOBER 13 19 67

Application for plugging approved OCTOBER 13 19 67

Plugging commenced OCTOBER 13 19 67

Plugging completed OCTOBER 13 19 67

Reason for abandonment of well or producing formation DRY HOLE

If a producing well is abandoned, date of last production 19

Was permission obtained from the Conservation Division or its agents before plugging was commenced? YES

Name of Conservation Agent who supervised plugging of this well E. EVES, SUBLETTE, KANSAS

Producing formation Depth to top Bottom Total Depth of Well Feet

Show depth and thickness of all water, oil and gas formations.

OIL, GAS OR WATER RECORDS

CASING RECORD

FORMATION	CONTENT	FROM	TO	SIZE	PUT IN	PULLED OUT
				8-5/8"	1620'	NONE
				4-1/2"	4340'	2370'

RECEIVED
STATE CORPORATION COMMISSION
OCT 24 1967
CONSERVATION DIVISION
Wichita, Kansas

Describe in detail the manner in which the well was plugged, indicating where the mud fluid was placed and the method or methods used in introducing it into the hole. If cement or other plugs were used, state the character of same and depth placed, from feet to feet for each plug set.

HOLE WAS FULL OF MUD. SET 35 SACKS CEMENT PLUG @ 700'.
SET 15 SACKS CEMENT PLUG IN TOP OF 8-5/8" CASING.

(If additional description is necessary, use BACK of this sheet)

Name of Plugging Contractor HALLIBURTON COMPANY AND MCALISTER ENG. & WELL SERVICE

Address LIBERAL, KANSAS

STATE OF OKLAHOMA, COUNTY OF OKLAHOMA, ss.

HAROLD DAVIDOR (employee of owner) or (owner or operator) of the above-described well, being first duly sworn on oath, says: That I have knowledge of the facts, statements, and matters herein contained and the log of the above-described well as filed and that the same are true and correct. So help me God.

(Signature) Harold Davidor

4515 N. SANTA FE, OKLAHOMA CITY, OKLAHOMA
(Address)

SUBSCRIBED AND SWORN TO before me this 23RD day of OCTOBER, 1967

M. M. Miffin
Notary Public.

My commission expires MARCH 23, 1970