

WELL PLUGGING RECORD


FORMATION PLUGGING RECORD

STATE OF KANSAS STATE CORPORATION COMMISSION Give All Information Completely Make Required Affidavit Mail & Deliver Report to: Conservation Division State Corporation Commission 800 Bittling Building Wichita, Kansas

Strike out upper line when reporting plugging of formations.

Summer County Sec. 19 Twp. 30S Rge. 4W (X) (W)

Location as "NE 1/4 NW 1/4 SW 1/4" or footage from lines. 530' SL, 330' EL. Lease Owner: Bridgeport Oil Company, Inc. Lease Name: Kelley "A" Well No. 1 Office Address: 914 Central Building, Wichita 2, Kansas Character of Well (completed as Oil, Gas or Dry Hole): Dry Hole Date well completed: December 31 19. 47 Application for plugging filed: December 31 19. 47 Application for plugging approved: December 31 19. 47 Plugging commenced: 10:00 A.M., December 31 19. 47 Plugging completed: 7:00 P.M., December 31 19. 47 Reason for abandonment of well or producing formation: Dry

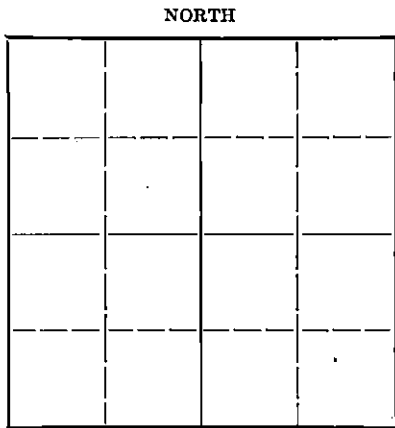

Locate well correctly on above Section Plat

If a producing well is abandoned, date of last production: None 19. Was permission obtained from the Conservation Division or its agents before plugging was commenced?: Yes

Name of Conservation Agent who supervised plugging of this well: Mr. Buffington, Gueda Spring, Kansas Producing formation: Kansas City Depth to top: 3590 Bottom: 3640 Total Depth of Well: 3640 Feet Show depth and thickness of all water, oil and gas formations.


OIL, GAS OR WATER RECORDS

CASING RECORD

Table with 7 columns: Formation, Content, From, To, Size, Put In, Pulled Out. Rows include Sand (Dry, 0 to 45), Red Bed (Water, 140 to 190, 8-5/8, 258, 0), and Kansas City Lime (Dry, 3590 to 3640, 0, 0, 0).

Describe in detail the manner in which the well was plugged, indicating where the mud fluid was placed and the method or methods used in introducing it into the hole. If cement or other plugs were used, state the character of same and depth placed, from feet to feet for each plug set.

Filled hole with heavy mud from 3640 to 258 - bridge and 15 sacks cement 258' to 213' - heavy mud 213' to 38' - bridge and 10 sacks cement 38' to bottom of cellar.

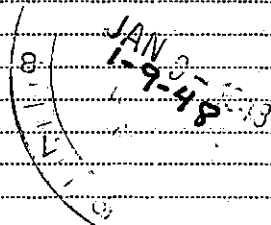

(If additional description is necessary, use BACK of this sheet)

Correspondence regarding this well should be addressed to: Bridgeport Oil Company, Inc. Address: 914 Central Building, Wichita 2, Kansas.


STATE OF Kansas, COUNTY OF Sedgwick, ss. Frank Leach (employee of owner) or (owner or operator) of the above-described well, being first duly sworn on oath, says: That I have knowledge of the facts, statements, and matters herein contained and the log of the above-described well as filed and that the same are true and correct. So help me God.

(Signature) [Signature] 914 Central Building, Wichita 2, Kansas (Address)

SUBSCRIBED AND SWORN to before me this 5th day of January, 1948.

[Signature] Notary Public.

My commission expires April 13, 1949

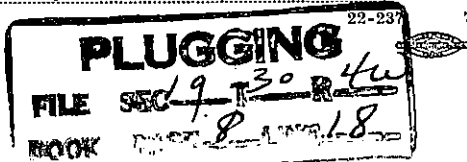

BRIDGEPORT OIL COMPANY, INC.
914 Central Building
Wichita 2, Kansas

Well Log Kelley "A" No. 1
530' South Line, 330' East Line
SE/4 19-30S-4W
Sumner County, Kansas

Elevation 1500'
Date Commenced December 12, 1947
Date Completed December 31, 1947
Rotary Tools 0' to 3638' T.D.

Casing Record:
8-5/8" casing cemented at
258' with 200 sacks cement.

<u>LOG</u>		<u>FORMATION TOPS - DE</u>	
0	45	Sand and Shale	Kansas City 3588
45	195	Shale and Shells, Red Bed	Total Depth 3638
195	258	Red Bed, Shale and Shells	
258	410	Red Bed and Shells	
410	910	Shale, Shells and Salt	
910	995	Lime and Shale	
995	1140	Broken Lime	
1140	1455	Lime and Shale	Dry and Abandoned
1455	1540	Shale and Shells	
1540	1835	Lime and Shale	
1835	1855	Sand	
1855	2640	Shale and Lime	
2640	2820	Lime	
2820	3281	Lime and Shale	
3281	3398	Sand	
3398	3596	Lime and Shale	
3596	3640	Lime, Rotary Table	
3640	Equals 3638	Derrick Floor	

I, Frank Leach, do hereby certify that the above log is correct to the best of my knowledge and belief.

BRIDGEPORT OIL COMPANY, INC.
By: Frank Leach

PLUGGING
FILE SEC 19 T 30 R 4W
BOOK PAGE 8 LINE 18