

15-191-00424-0000

STATE OF KANSAS  
STATE CORPORATION COMMISSION


Give All Information Completely  
Make Required Affidavit  
Mail or Deliver Report to:  
Conservation Division  
State Corporation Commission  
211 No. Broadway  
Wichita, Kansas

WELL PLUGGING RECORD

Summer County, Sec. 15 Twp. 30S Rge. 4W (6) (W)

Location as "NE/CNW&SW" or footage from lines NE SW NW  
Lease Owner National Cooperative Refinery Association  
Lease Name Addie Golton Well No. 1  
Office Address 305 Rule Building, Wichita, Kansas  
Character of Well (completed as Oil, Gas or Dry Hole) Dry Hole  
Date well completed September 8, 1957  
Application for plugging filed September 9, 1957  
Application for plugging approved September 10, 1957  
Plugging commenced September 8, 1957  
Plugging completed September 8, 1957  
Reason for abandonment of well or producing formation Dry Hole

NORTH

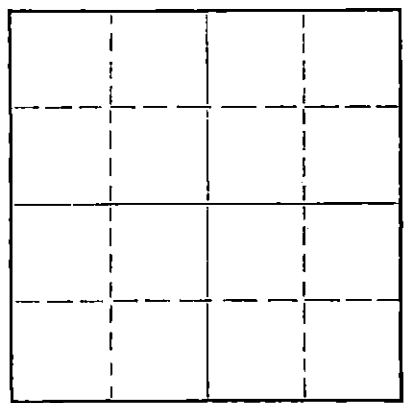

Locate well correctly on above Section Plat

If a producing well is abandoned, date of last production 19  
Was permission obtained from the Conservation Division or its agents before plugging was commenced? Yes

Name of Conservation Agent who supervised plugging of this well W. G. Buffington  
Producing formation Depth to top Bottom Total Depth of Well 4603 Feet  
Show depth and thickness of all water, oil and gas formations.

OIL, GAS OR WATER RECORDS

CASING RECORD

FORMATION	CONTENT	FROM	TO	SIZE	PUT IN	PULLED OUT
				8 5/8"	225'	None

Describe in detail the manner in which the well was plugged, indicating where the mud fluid was placed and the method or methods used in introducing it into the hole. If cement or other plugs were used, state the character of same and depth placed, from feet to feet for each plug set.  
Mudded hole to 220', set plug plus 15 sacks of cement. Mudded hole to 35', set plug plus 10 sacks of cement on up to base of cellar.

Name of Plugging Contractor Garvey Drilling Company  
Address 311 East Third Street, Wichita, Kansas

STATE OF Kansas, COUNTY OF Sedgwick  
C. R. Sears (employee of owner) or (owner or operator) of the above-described well, being first duly sworn on oath, says: That I have knowledge of the facts, statements, and matters herein contained and the log of the above-described well as filed and that the same are true and correct. So help me God.  
(Signature) C. R. Sears (C. R. Sears)  
305 Rule Building, Wichita, Kansas (Address)

SUBSCRIBED AND SWORN TO before me this 30th day of September, 1957

My commission expires November 26, 1960

Notary Public  
**PLUGGING COMMISSION**  
 STATE OF KANSAS  
 FILE SEC. 15 T. 30 R. 4W 10-1-57  
 BOOK PAGE 430 LINE 43  
 COM. DIVISION

# WELL LOG

15-191-00424-0000

COMPANY NATIONAL COOPERATIVE REFINERY ASSN.

SEC. 15 T. 30S R. 4W

FARM A. GULTON

NO. 1

LOC. NE, SW, NW

TOTAL DEPTH 4603'


COUNTY Sumner Co., Kansas

COMM. August 21, 1957

COMP. September 8, 1957

CONTRACTOR

GARVEY DRILLING COMPANY

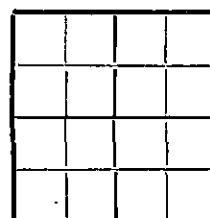

CASING 8 5/8" @ 225' w/175 sax.

ELEVATION 1407' DF

PRODUCTION D & A

FIGURES INDICATE BOTTOM OF FORMATIONS

20	Clay
225	Red bed & shale
525	Shale & shells
890	Shale
2180	Lime & shale
2573	Shale
2830	Shale & lime
2990	Shale
3398	Shale & lime
3643	Lime
3755	Lime & shale
3801	Lime
4062	Lime & shale
4094	Lime
4205	Cherty lime
4349	Lime
4357	Chert
4360	Lime
4374	Chert
4430	Shale & lime
4466	Shale
4511	Sand
4548	Sand & shale
4603	Lime & shale
4603	T. D.

RECEIVED  
 STATE COMMISSION  
 OCT 1 - 1957  
 CONSERVATION DIVISION  
 Wichita, Kansas

State of KANSAS }  
 County of BARTON } SS:

I, Verne A. Morris of Garvey Drilling Co.

upon oath state that the above and foregoing is a true and correct copy of the log of the #1 A. Golton well

Subscribed and sworn to before me this 13th day of September 19 57

My Commission Expires: November 12, 1958

PLUGGING  
 FILE SEC. 15 T. 30 R. 4W  
 BOOK PAGE 43 LINE 42  
 NOTARY PUBLIC

*Verne A. Morris*