


STATE OF KANSAS  
STATE CORPORATION COMMISSION

WELL PLUGGING RECORD

Give All Information Completely  
Make Required Affidavit  
Mail or Deliver Report to:  
Conservation Division  
State Corporation Commission  
211 No. Broadway  
Wichita, Kansas

Sumner County, Sec. 36 Twp. 30S Rge. (E) 2 (W)  
Location as "NE/CNW/SW" or footage from lines C SW SW SE  
Lease Owner Musgrove Petroleum Corporation  
Lease Name HAINES Well No. 1  
Office Address 801 Union Center, Wichita, Kansas.  
Character of Well (completed as Oil, Gas or Dry Hole) Dry  
Date well completed February 11, 19 59  
Application for plugging filed verbally February 10, 19 59  
Application for plugging approved verbally February 10, 19 59  
Plugging commenced February 11, 19 59  
Plugging completed February 11, 19 59  
Reason for abandonment of well or producing formation Dry

NORTH

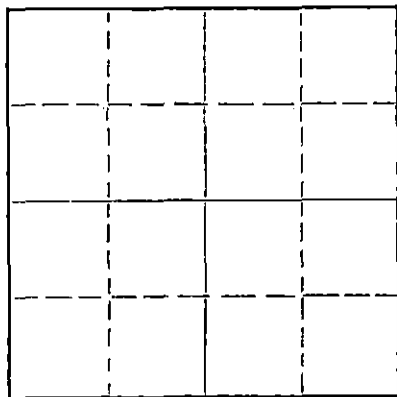

Locate well correctly on above  
Section Plat

If a producing well is abandoned, date of last production 19  
Was permission obtained from the Conservation Division or its agents before plugging was commenced? verbally, yes.

Name of Conservation Agent who supervised plugging of this well \_\_\_\_\_  
Producing formation \_\_\_\_\_ Depth to top \_\_\_\_\_ Bottom \_\_\_\_\_ Total Depth of Well 3794' Feet  
Show depth and thickness of all water, oil and gas formations.

OIL, GAS OR WATER RECORDS

CASING RECORD

FORMATION	CONTENT	FROM	TO	SIZE	PUT IN	PULLED OUT
				8-5/8"	438'	

Describe in detail the manner in which the well was plugged, indicating where the mud fluid was placed and the method or methods used in introducing it into the hole. If cement or other plugs were used, state the character of same and depth placed, from \_\_\_\_\_ feet to \_\_\_\_\_ feet for each plug set.

Filled hole with heavy mud to 240'.  
Set 1st plug at 240' w/ 1/4 sk hulls & 15 sx cement.  
Filled hole with heavy mud to 40'.  
Set 2nd plug at 40' w/ 1/4 sk hulls & 10 sx cement.

RECEIVED  
STATE CORPORATION COMMISSION  
FEB 18 1959  
CONSERVATION DIVISION  
Wichita, Kansas

(If additional description is necessary, use BACK of this sheet)  
Name of Plugging Contractor Musgrove Petroleum Corporation  
Address 801 Union Center, Wichita, Kansas.

STATE OF Kansas, COUNTY OF Sedgwick  
Emil E. Bowers (employee of owner) or (owner or operator) of the above-described well, being first duly sworn on oath, says: That I have knowledge of the facts, statements, and matters herein contained and the log of the above-described well as filed and that the same are true and correct. So help me God.

(Signature) Emil E. Bowers  
801 Union Center, Wichita, Kansas.  
(Address)

SUBSCRIBED AND SWORN TO before me this 17th day of February, 19 59

Leah Joyce Herkel  
Leah Joyce Herkel Notary Public.

My commission expires June 16, 1959

PLUGGING  
FILE SEC. 36 T 30 R 2W  
BOOK PAGE 18 LINE 15

CONTRACTOR'S WELL LOG

COMPANY:	Musgrove Petroleum Corporation
CONTRACTOR:	Musgrove Petroleum Corporation
FARM:	HAINES #1
LOCATION:	C SW SW SE, Sec. 36-30S-2W Sumner County, Kansas
COMMENCED:	January 31, 1959
COMPLETED:	February 11, 1959

---

0	140	Surface sand & shells
140	450	Shale & shells
450	3740	Shale & lime
3740	3759	Lime & Dolomite
3759	3794	Lime
3794		Rotary Total Depth

---

Set 8-5/8" surface pipe at 438' with 360 sx Sunset cement with 1/4# Flo-seal per sack.  
Dry and Abandoned.

---

ELEVATION:	1318' K. B.	TOPS: Kansas City	3078'	(-1760)
		Miss. Chert	3722'	(-2404)
		Miss. Lime	3725'	(-2407)

---

STATE OF KANSAS            )  
                                      ) SS  
COUNTY OF SEDGWICK    )

I, Emil E. Bowers, do hereby certify that the above and foregoing is a true and correct copy of the log of the HAINES #1, C SW SW SE, Section 36-30S-2W, Sumner County, Kansas, as reflected by the files of the Musgrove Petroleum Corporation.

MUSGROVE PETROLEUM CORPORATION

BY Emil E. Bowers  
Secretary-Treasurer

Subscribed and sworn to before me, a Notary Public, in and for Sedgwick County, Kansas, this 17th day of February, 1959.

Leah Faye Heferke  
Leah Faye Heferke, Notary Public

My commission expires June 16, 1959.

RECEIVED  
STATE CORPORATION COMMISSION

FEB 18 1959

CONSERVATION DIVISION

PLUGGING  
FILE SEC 36T.30. R 2W  
BOOK PAGE 18 LINE 15