


STATE OF KANSAS  
STATE CORPORATION COMMISSION

Form CP-4

WELL PLUGGING RECORD

Give All Information Completely  
Make Required Affidavit  
Mail or Deliver Report to:  
Conservation Division  
State Corporation Commission  
212 No. Market  
Wichita, Kansas

NORTH

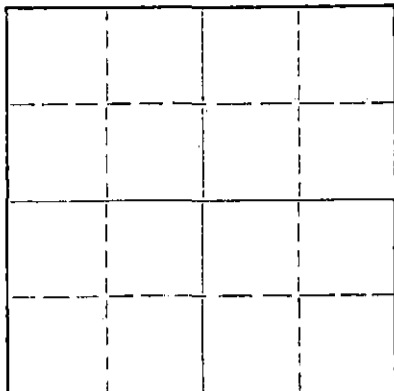

Locate well correctly on above  
Section Plat

SUMNER County, Sec. 35 Twp. 30S Rge. 2W (E) (W)  
Location as "NE/CNW/SW" or footage from lines S-W--NW-SE  
Lease Owner FALCON SEABOARD DRUG CO.  
Lease Name RENNER Well No. 2  
Office Address 9825 SOUTH MANOR CIRCLE  
Character of Well (completed as Oil, Gas or Dry Hole) OIL  
Date well completed 7-29 19 56  
Application for plugging filed FEBRUARY 19 67  
Application for plugging approved \_\_\_\_\_ 19 \_\_\_\_\_  
Plugging commenced 3-12- 19 67  
Plugging completed 3-14- 19 67  
Reason for abandonment of well or producing formation DRY

If a producing well is abandoned, date of last production \_\_\_\_\_ 19 \_\_\_\_\_  
Was permission obtained from the Conservation Division or its agents before plugging was commenced? YES

Name of Conservation Agent who supervised plugging of this well HOWARD HESS  
Producing formation \_\_\_\_\_ Depth to top \_\_\_\_\_ Bottom \_\_\_\_\_ Total Depth of Well 3924' Feet  
Show depth and thickness of all water, oil and gas formations.

OIL, GAS OR WATER RECORDS

CASING RECORD

FORMATION	CONTENT	FROM	TO	SIZE	PUT IN	PULLED OUT
				10"	425'	NONE
				5	3922'	1474.55'

Describe in detail the manner in which the well was plugged, indicating where the mud fluid was placed and the method or methods used in introducing it into the hole. If cement or other plugs were used, state the character of same and depth placed, from \_\_\_\_\_ feet to \_\_\_\_\_ feet for each plug set.

ROTTOM PLUGGED w/5 SACKS CEMENT  
BRIDGE AT 240#  
ROCK TO 225  
READY MIX CONCRETE TO SURFACE

RECEIVED  
STATE CORPORATION COMMISSION

MAR 23 1967  
3-23-67

CONSERVATION DIVISION  
Wichita, Kansas

(If additional description is necessary, use BACK of this sheet)  
Name of Plugging Contractor WINFIELD OIL FIELD SERVICE INC.  
Address Box 952 WINFIELD, KANSAS

STATE OF KANSAS, COUNTY OF SUMNER, ss.  
GLEN S. KIER (employee of owner) or (owner or operator) of the above-described well, being first duly sworn on oath, says: That I have knowledge of the facts, statements, and matters herein contained and the log of the above-described well as filed and that the same are true and correct. So help me God.

(Signature) Glen S. Kier  
Box 952 Winfield, Kans (Address)

SUBSCRIBED AND SWORN TO before me this 21st day of MARCH, 19 67

Anna L. Smith  
Notary Public.

My commission expires JULY 13, 1970

RECEIVED  
STATE CORPORATION COMMISSION

FEB 15 1967

CONSERVATION DIVISION  
Wichita, Kansas

## FALCON SEABOARD DRILLING COMPANY

## Renner Lease No. 2

S.W. N.W. S.E. Section 35  
30 S. 2 W. Sumner County, KansasSurface: 17 Jt. 10 3/4" - 32.75# casing - 527'  
cemented w/ 550 cu. ft. w/270 Gal. cement circulated.13 Jt. 5" E.H. - 19.50# Drill pipe ret. @ 3922' cemented  
with 1250 cu. ft. posmix cement w/1/4" flow head. Top of  
cement @ 1495'.

3790' 2 3/8" - 4.70# J55 Tubing.

3750' 3/4" x 25' Sucker rods.

1- 2" x 1 1/2" x 12" B.H. Pump

1- 10 3/4" x 5" Mindeliter casing head.

1- 5 1/2" x 2" EUS 8rd thd. 4 in 1 Mindeliter tubing Head  
w/2- 2" Outlets.

1- 1 1/2" x 16' Steel Polish rod.

1- 1 1/2" x 6' Brass Polish rod liner.

1- 2 3/8" OD 8rd x 2" x 1 1/2" x 1" Hercules Stuffing Box.

1- Bethlehem Pumping Unit, Serial # R- 3241 Rating 16.  
500 Model 11-4D-16 SP.1- 5 1/2" x 6" Ajax Gas Engine w/twin disc clutch & drive  
shieva.

1390' 1" Gas line from #2 to #3.

400' 3" Std Black line pipe- Flow line to tank battery.

1- 3" I B B M check valve.

1- 3" x 2" Swaged nipple.

2- 2" Std. Brass check valves.

3- 2" 175# Lubricated plug valves.

4- 2" Std. Mall Tees.

2- 2" S.S. Dull plugs.

4- 2" 1000# Hammer Flanges