


STATE OF KANSAS
STATE CORPORATION COMMISSION

Form CP-4

WELL PLUGGING RECORD

Give All Information Completely
Make Required Affidavit
Mail or Deliver Report to:
Conservation Division
State Corporation Commission
212 No. Market
Wichita, Kansas

NORTH

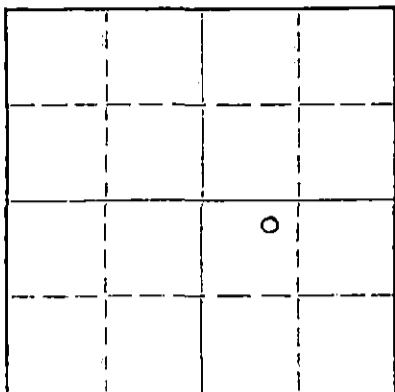

Locate well correctly on above
Section Plot

SUMMER County. Sec. 35 Twp. 30S Rge. 2W (E) (W)
Location as "NE/CNW/SW" or footage from lines: NE-NW-SE
Lease Owner: FALCON-SEABOARD DELY COMPANY
Lease Name: RENNER Well No. I
Office Address: 3801 SOUTH BRYANT, OKLAHOMA CITY, OKLAHOMA
Character of Well (completed as Oil, Gas or Dry Hole) OIL
Date well completed: 5-15-19 56
Application for plugging filed: FEBRUARY 19 67
Application for plugging approved: 19
Plugging commenced: 3-6- 19 67
Plugging completed: 3-8- 19 67
Reason for abandonment of well or producing formation: DRY

If a producing well is abandoned, date of last production: 19
Was permission obtained from the Conservation Division or its agents before plugging was commenced?

Name of Conservation Agent who supervised plugging of this well
Producing formation: Depth to top: Bottom: Total Depth of Well 3853' Feet
Show depth and thickness of all water, oil and gas formations.

OIL, GAS OR WATER RECORDS

CASING RECORD

FORMATION	CONTENT	FROM	TO	SIZE	PUT IN	PULLED OUT
				9-5/8 7"	450' 3853'	NONE 2878.80'

Describe in detail the manner in which the well was plugged, indicating where the mud fluid was placed and the method or methods used in introducing it into the hole. If cement or other plugs were used, state the character of same and depth placed, from feet to feet for each plug set.

BOTTOM PLUGGED W/5 SACKS CEMENT
BRIDGE AT 240'
ROCK TO 225'
READY MIX TO SURFACE

13-
STATE CORPORATION COMMISSION
MAR 13 1967
3-13-67
CONSERVATION DIVISION
WICHITA, KANSAS

(If additional description is necessary, use BACK of this sheet)
Name of Plugging Contractor: WINFIELD OIL FIELD SERVICE INC.
Address: P. O. Box 952, WINFIELD, KANSAS

STATE OF KANSAS, COUNTY OF COWLEY, ss.
CLEM S. KIER (employee of owner) or (owner or operator) of the above-described well, being first duly sworn on oath, says: That I have knowledge of the facts, statements, and matters herein contained and the log of the above-described well as filed and that the same are true and correct. So help me God.

(Signature) Clem S. Kier
Box 952, Winfield, Kansas (Address)

SUBSCRIBED AND SWORN TO before me this 10TH day of MARCH, 19 67

My commission expires JULY 13, 1970

Notary Public.

FALCON SEABOARD DRILLING COMPANY

Renner Lease No. 1

N.E. N.W. S.A. Section 35
30 S 2 W Sumner Co. Kansas

9 5/8" - Surface Casing set @ 450' - Cement circulated
w/450 cu. ft w/ 2% Gel.

3852' - 123 jt. 7" CD 20# casing set and cemented w/200
cu. ft. Pozmix #1. Top cement @ 3175'.

3786' - 127 jt. 2 3/8" CD 4.60# J 55 Tubing.

1- 2 3/8" x 12" Seating Nipple.

1- 2 3/8" x 3" Perforated Tubing Pup Jt.

1- 1 1/2" x 12" Bottom Hole Pump.

3750' - 150 - 3/4" x 25' sucker rods.

1- Cabot Pumping Unit, Serial # T- 101108 UY-
Type T-10 UM - 15 DC. Rating 19600

1- 2C. Fairbanks-Morris Gas Engine Serial # 930078
w/clutch & drive shieve.

670' - 1" Gas line.

992' - 3" Flow line to Tank Battery.

1- 9 5/8" x 7" CD Casing Head w/2 - 2" Outlets.

1- 7" CD x 2" - 4' in 1 Hindleter Tubing Head w/
2-2" Outlets.

1- 2 3/8" x 2" x 1 1/2" x 1" Hercules Stuffing Box

2- 2" Std. Brass Check Valves

1- 3" O B B M check valve

1- 3" x 2" S.S. Swaged nipple

1- 2" x 1" " " " "

RECEIVED
STATE CORPORATION COMMISSION
FEB 15 1967
CONSERVATION DIVISION
Wichita, Kansas