

STATE CORPORATION COMMISSION OF KANSAS
OIL & GAS CONSERVATION DIVISION
WELL COMPLETION OR RECOMPLETION FORM
ACO-1 WELL HISTORY
DESCRIPTION OF WELL AND LEASE

Operator: License # 5003
Name McCoy Petroleum Corporation
Address 110 S. Main, Suite 500
City/State/Zip Wichita, Kansas, 67202

Purchaser

Operator Contact Person Roger McCoy
Phone (316) 265-9697

Contractor: License # 5658
Name Sweetman Drilling, Inc.

Wellsite Geologist John Hastings
Phone (316) 265-9697

Designate Type of Completion
 New Well Re-Entry Workover

Oil SWD Temp Abd
 Gas Inj Delayed Comp.
 Dry Other (Core, Water Supply etc.)

If CWNO: old well info as follows:
Operator
Well Name
Comp. Date Old Total Depth

WELL HISTORY

Drilling Method:
 Mud Rotary Air Rotary Cable
7-20-89 8-1-89 8-2-89
Spud Date Date Reached TD Completion Date
6470'
Total Depth PBTD

Amount of Surface Pipe Set and Cemented at 1784' feet
Multiple Stage Cementing Collar Used? Yes No
If yes, show depth set feet
If alternate 2 completion, cement circulated from feet depth to w/ SX cmt
Cement Company Name
Invoice # A I E DFO

API NO. 15-189-21-363-00-00
County Stevens
NE NW SE Sec 21 Twp 32 Rge 35 East
2310 Ft North from Southeast Corner of Section
1650 Ft West from Southeast Corner of Section
(Note: Locate well in section plat below)


Lease Name Fern Sessler Well # 2-21

Field Name Wildcat

Producing Formation

Elevation: Ground 3009 KB 3019

Section Plat

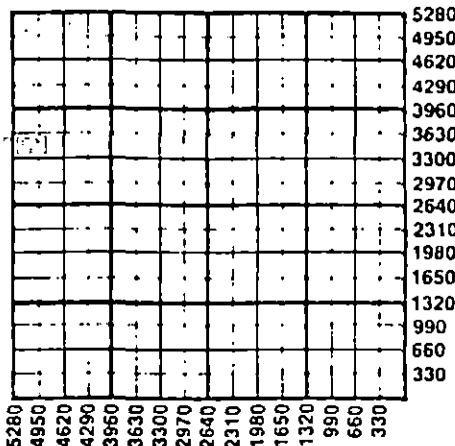

RECEIVED
AUG - 7 1989
GOVERNMENT OF KANSAS
8-7-89

WATER SUPPLY INFORMATION

Disposition of Produced Water: Disposal
Docket # Repressuring

Questions on this portion of the ACO-1 call:
Water Resources Board (913) 296-3717

Source of Water:
Division of Water Resources Permit #

Groundwater Ft North from Southeast Corner
(Well) Ft West from Southeast Corner of
Sec Twp Rge East West

Surface Water Ft North from Southeast Corner
(Stream, pond etc) Ft West from Southeast Corner
Sec Twp Rge East West

Other (explain)
(purchased from city, R.W.D. #)

INSTRUCTIONS: This form shall be completed in triplicate and filed with the Kansas Corporation Commission, 200 Colorado Derby Building, Wichita, Kansas 67202, within 120 days of the spud date of any well. Rule 82-3-130, 82-3-107 and 82-3-106 apply. Information on side two of this form will be held confidential for a period of 12 months if requested in writing and submitted with the form. See rule 82-3-107 for confidentiality in excess of 12 months. One copy of all wireline logs and drillers time log shall be attached with this form. Submit CP-4 form with all plugged wells. Submit CP-111 form with all temporarily abandoned wells.

All requirements of the statutes, rules and regulations promulgated to regulate the oil and gas industry have been fully complied with and the statements herein are complete and correct to the best of my knowledge.

Signature [Signature] Title President Date 8-2-89

Subscribed and sworn to before me this 4th day of August 1989
Notary Public Deborah Ann Paulus

Date Commission Expires 1-8-92

K.C.C. OFFICE USE ONLY
F Letter of Confidentiality Attached
C Wireline Log Received
D Drillers Timelog Received
Distribution
KCC SWD/Rep NGPA
KGS Plug Other
(Specify)

