


STATE OF KANSAS
STATE CORPORATION COMMISSION

WELL PLUGGING RECORD 15-129-00525-0000

Give All Information Completely
Make Required Affidavit
Mail or Deliver Report to
Conservation Division
State Corporation Comm.
245 North Water
Wichita, KS 67202

Morton County. Sec. 16 Twp. 31S Rge. 40W E/W
Location as "NE/CNW $\frac{1}{4}$ SW $\frac{1}{4}$ " or footage from lines _____
App. Gen. Sec. (100' SE C NW NW NW SE)
Lease Owner Louis A. Milburn
Lease Name Milburn Well No. 1
Office Address Johnson, Kansas 67855
Character of Well (Completed as Oil, Gas or Dry Hole) Gas

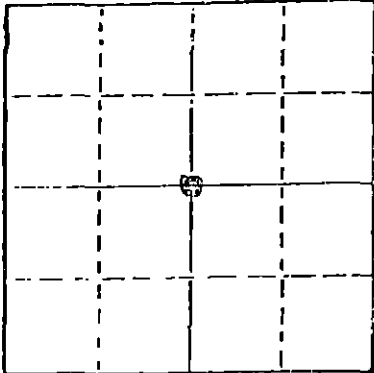

Locate well correctly on above
Section Plat

Date Well completed 3-13 1953
Application for plugging filed 8-18 1977
Application for plugging approved 8-22 1977
Plugging commenced 8-23 1977
Plugging completed 8-23 1977
Reason for abandonment of well or producing formation _____

Non productive
If a producing well is abandoned, date of last production
8-25 1976

Was permission obtained from the Conservation Division or
its agents before plugging was commenced? Yes

Name of Conservation Agent who supervised plugging of this well Clarence Thomas
Producing formation Hugoton Depth to top 2221 Bottom 2270 Total Depth of Well 2306
Show depth and thickness of all water, oil and gas formations.

OIL, GAS OR WATER RECORDS

CASING RECORD

FORMATION	CONTENT	FROM	TO	SIZE	PUT IN	PULLED OUT
				10 3/4	365	none
				7"	2296	none

Describe in detail the manner in which the well was plugged, indicating where the mud fluid was placed and the method or methods used in introducing it into the hold. If cement or other plugs were used, state the character of same and depth placed, from _____ feet to _____ feet for each plug set.

Pump 3 sks. of hulls & 25 sks. of cement from 2100 to 2270

Pump 25 sks. of cement from 365 to 265-11FD

Put 10 sks. of cement from 40 to 0

STATE CORPORATION COMMISSION
Wichita, Kansas

SEP 02 1977 9-2-77

CONSERVATION DIVISION
Wichita, Kansas

(If additional description is necessary, use BACK of this sheet)

Name of Plugging Contractor Sargents Casing Pulling Service
Box 506 Liberal, Kansas 67901

STATE OF Kansas COUNTY OF Seward, ss.

Louis A. Milburn (employee of owner) or (owner or operator)
of the above-described well, being first duly sworn on oath, says: That I have knowledge of the facts, statements, and matters herein contained and the log of the above-described well as filed and that the same are true and correct. So help me God.

(Signature) Louis A. Milburn
Johnson KS 67855
(Address)

SUBSCRIBED AND SWORN TO before me this 30th day of Aug., 19 77

Dorothy Sargent
Notary Public.

My commission expires Dec. 11th. 1977



WELL LOG BUREAU - KANSAS GEOLOGICAL SOCIETY
508 East Murdock, Wichita, Kansas

COPY


15-129-00525-0000

Company: TRANS ERA PETROLEUM, INC.
Farm: Milburn No. 1

SEC. 16 T. 31 R. 40W
NW NW NW SE
100' S. & E. of Center

Total Depth. 2306
Comm. 1-25-53 Comp. 1-30-53
Shot or Treated.
Contractor.
Issued. 3-28-53

County Morton KANSAS

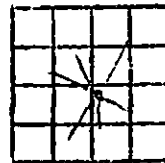

Elevation. 3308

Production. 2,065,000 Gas

CASING:

10 3/4" 365' cem. w/300 sx
7" 2296' cem. w/300 sx

Figures indicate Bottom of Formations.

surface soil, clay	55
sand, gravel	85
sand, shale	130
coarse gravel	230
shale blue	320
sand	340
shale, shells	395
sand, shale	510
red bed, shale	1065
anhydrite, shale	1155
shale	1365
red bed, shale	1430
shale, shells	1570
anhydrite	1600
lime, shale	1660
shale, shells	1690
shale, lime	2306
Total Depth	

Scout Tops:	
Herington	2232
Krider	2244
Winfield	2292
T. D.	2306

RECEIVED
STATE CORPORATION COMMISSION

AUG 22 1977

CONSERVATION DIVISION
Wichita, Kansas