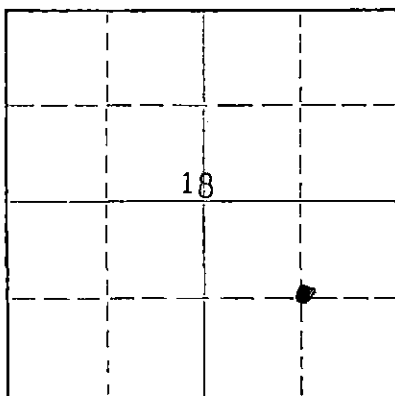


Give All Information Completely
Make Required Affidavit
Mail or Deliver Report to:
Conservation Division
State Corporation Commission
211 No. Broadway
Wichita, Kansas

WELL PLUGGING RECORD

NORTH

Locate well correctly on above
Section Plat

Morton County, Sec. 18 Twp. 31S Rge. 40W (E) (W)
Location as "NE/CNW/SW" or footage from lines C SE/4
Lease Owner Southwestern Exploration Company
Lease Name Breeding Well No. 1
Office Address 352 North Broadway, Wichita, Kansas
Character of Well (completed as Oil, Gas or Dry Hole) Dry Hole
Date well completed January 25 19 57
Application for plugging filed " 19 "
Application for plugging approved January 26 19 "
Plugging commenced April 26 19 "
Plugging completed " 27 19 "
Reason for abandonment of well or producing formation Non-Commercial

If a producing well is abandoned, date of last production 19
Was permission obtained from the Conservation Division or its agents before plugging was commenced? Yes

Name of Conservation Agent who supervised plugging of this well Mr. M. A. Rives

Producing formation Depth to top Bottom Total Depth of Well 2300' Feet RTD

Show depth and thickness of all water, oil and gas formations.

OIL, GAS OR WATER RECORDS

CASING RECORD

FORMATION	CONTENT	FROM	TO	SIZE	PUT IN	PULLED OUT
				8-5/8	488	-0-
				5-1/2	2300	-0-

Describe in detail the manner in which the well was plugged, indicating where the mud fluid was placed and the method or methods used in introducing it into the hole. If cement or other plugs were used, state the character of same and depth placed, from feet to feet for each plug set.

Cleaned out cellar and measured into TD. Put in 50' sand and dumped 5 sacks cement. Cut off casing head and plugged well with mud to 600'. Set rock bridge and dumped 10 sacks cement. Filled hole with mud to 30'. Set permanent rock bridge and dumped 5 sacks for cap on well.

(If additional description is necessary, use BACK of this sheet)

Name of Plugging Contractor J. O. Forbes, d/b/a Forbes Casing Pulling Co.
Address Box 221, Great Bend, Kansas

STATE OF KANSAS, COUNTY OF SEDGWICK
M. S. Davis

(employee of owner) or (owner or operator) of the above-described well, being first duly sworn on oath, says: That I have knowledge of the facts, statements, and matters herein contained and the log of the above-described well as filed and that the same are true and correct. So help me God.

(Signature)

M. S. Davis
352 North Broadway, Wichita, Kansas
(Address)

SUBSCRIBED AND SWORN TO before me this 8 day of May, 19 57


My commission expires 10/28/1959

STATE CORPORATION COMMISSION
5-9-57
MAY 9 - 1957

PLUGGING

FILE SEC 18 T. 31 R. 40W
BOOK PAGE 136 LINE 30

CONSERVATION DIVISION
Wichita, Kansas

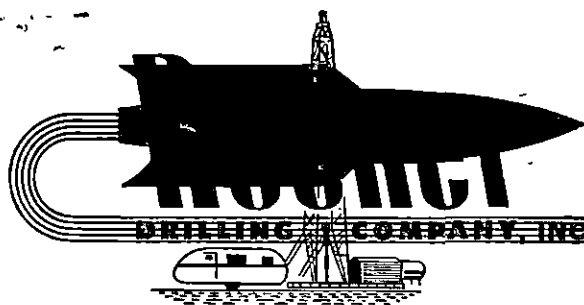

DRILLING COMPANY, INC. • PHONE 3-1229 • 352 N. BROADWAY • WICHITA, KANSAS

15-129-60554-0006

Southwestern Exploration Company
#1 Breeding
C SE/4 Section 18-31S-40W
Morton County, Kansas

Southwestern Exploration Company
352 North Broadway
Wichita, Kansas

Elevation: 3318 Gr.; 3320 D.F.; 3322 R.B.
Spudded: December 27, 1956
Rotary Completed: December 31, 1956
Contractor: Rocket Drilling Company, Inc.

CASING RECORD

488' 8-5/8" O.D. 24# seamless casing cemented with 300 sacks cement.
2300' 5-1/2" O.D. 14# seamless casing cemented with 400 sacks cement.

DRILLERS LOG

Clay	0 to 40	Sand & Quartz	1152
Sand	225	Red Shale & Sand	1565
Shale	250	Lime & Shale	1910
Sand & Shale	460	Shale	1940
Red Bed	640	Lime & Shale	2080
Sand & Gyp	720	Red Shale, Lime & Shells	2185
Red Bed	1055	Shale & Lime	2300 T.D.

STATE OF KANSAS)
COUNTY OF SEDGWICK) SS

I hereby certify that to the best of my knowledge and belief the foregoing log is true and correct.

5-9-57

RECEIVED
STATE OF KANSAS
COMMISSIONER OF GEOL. & NAT. RES.
DIVISION
MAY 9 - 1957
L. H. Myrick
Rocket Drilling Company, Inc.

Subscribed and sworn to before me, a Notary Public, in and for the County and State aforesaid, this 3rd day of January, 1957.

My Commission expires:
10/28/1959

Notary Public

PLUGGING

FILE SEC 18 T 31 R 40W
BOOK PAGE 136 LINE 30