

STATE OF KANSAS
STATE CORPORATION COMMISSION

WELL PLUGGING RECORD

15-129-26113-0000

Give All Information Completely
Make Required Affidavit
Mail or Deliver Report to
Conservation Division
State Corporation Comm.
245 North Water
Wichita, KS 67202

Morton County, Sec. 18 Twp. 31S Rge. 40W E/W
Location as "NE/CNW $\frac{1}{4}$ SW $\frac{1}{4}$ " or footage from lines
C - SW/4


Lease Owner Tideway
Lease Name Light Well No. 1-18
Office Address 310 W.H. Bldg. 1616 W.L. South Houston, Texas

Character of Well (Completed as Oil, Gas or Dry Hole) Dry Hole

Date Well completed 5-23- 19 80
Application for plugging filed 7-2 19 80
Application for plugging approved 7-9- 19 80
Plugging commenced 7-9- 19 80
Plugging completed 7-11 19 80

Reason for abandonment of well or producing formation
Dry Hole
If a producing well is abandoned, date of last production 19

Was permission obtained from the Conservation Division or its agents before plugging was commenced? Yes

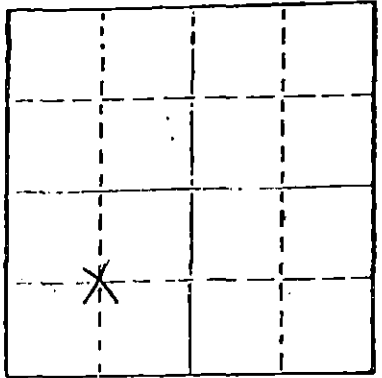

Locate well correctly on above Section Plat

Name of Conservation Agent who supervised plugging of this well Clarence Thomas
Producing formation Winfield Depth to top 2,272 Bottom 2,278 Total Depth of Well 2650
Show depth and thickness of all water, oil and gas formations.

| OIL, GAS OR WATER RECORDS | | | | | | CASING RECORD | |
|---------------------------|---------|------|----|-------|--------|---------------|--|
| FORMATION | CONTENT | FROM | TO | SIZE | PUT IN | PULLED OUT | |
| | | | | 8 5/8 | 660 | none | |
| | | | | 4 1/2 | 2645 | 917 | |
| | | | | | | | |
| | | | | | | | |

Describe in detail the manner in which the well was plugged, indicating where the mud fluid was placed and the method or methods used in introducing it into the hold. If cement or other plugs were used, state the character of same and depth placed, from feet to feet for each plug set,

Pump 20 sks. of cement @ 2612 to 2400
Pump 35 sks. of cement @ 660 to 560
Put 10 sks. of cement @ 40 to 0

RECEIVED
STATE CORPORATION COMMISSION
JUL 24 1980
7-31-80
CONSERVATION DIVISION
Wichita, Kansas

(If additional description is necessary, use BACK of this sheet)

Name of Plugging Contractor Sargents Casing Pulling Service Box 506 Liberal, Kansas Ks. No. 511

STATE OF Texas COUNTY OF Harris, ss.
Charles B. Wilson, Jr. (employee of owner) or (owner or operator)

of the above-described well, being first duly sworn on oath, says: That I have knowledge of the facts, statements, and matters herein contained and the log of the above-described well as filed and that the same are true and correct. So help me God.

(Signature) Charles B. Wilson, Jr.
1616 West Loop South, Suite 310
Houston, Texas (Address) 77027

SUBSCRIBED AND SWORN TO before me this 29th day of July, 19 80

Gladys J. Taylor
Notary Public.

My commission expires 7-16-81

GLADYS J. TAYLOR
Notary Public in Harris County, Texas
My Commission Expires July 16, 1981
Bonded by Alexander Lovett, Lawyers Surety Corp.

TIDEWAY OIL PROGRAMS

Light No. 1 Well
Morton County, Kansas

15-129-264 B-0000

OPERATIONS COMMENCED: 11/1/79
OPERATIONS COMPLETED: 11/6/79

DRILLING LOG

| | | |
|------|-------------|---------------------|
| 11/1 | 0 - 660 | Sand, Gypsum |
| 11/2 | 660 - 1170 | Sand, Gypsum, Shale |
| 11/3 | 1170 - 2196 | Sand, Shale, Lime |
| 11/4 | 2196 - 2650 | Shale, Lime |

CASING RECORD

| | | |
|------|--|---------------|
| 11/2 | Ran 16 jts. of new 8-5/8" casing. Cemented with 235 sacks Howco light, 2% C.C. and 150 sacks Class H, 3% C.C. Set @ 655' | 660 of 8 5/8" |
| 11/6 | Ran 66 jts. of new 4-1/2", 9.5# casing. Set @ 2645'. Cemented with 300 sacks 50/50 poz-mix, 2% Gel, 10% salt. | |

RECEIVED
STATE CORPORATION COMMISSION

JUL 10 1980

CONSERVATION DIVISION
Wichita, Kansas