


15-129-00125-00 00

STATE OF KANSAS
STATE CORPORATION COMMISSION

Give All Information Completely
Make Required Affidavit
Mail or Deliver Report to:
Conservation Division
State Corporation Commission
800 Bitting Building
Wichita, Kansas

WELL PLUGGING RECORD

Morton County, Sec. 18 Twp. 31 Rge. 40 (E) (W)
Location as "NE/CNW $\frac{1}{4}$ SW $\frac{1}{4}$ " or footage from lines Gen. NE SW NW
Lease Owner J.M. Huber Corp.
Lease Name Breeding Well No. 1
Office Address Box 978
Character of Well (completed as Oil, Gas or Dry Hole) Dry Hole
Date well completed 10-8-53 19.
Application for plugging filed 10-9-53 19.
Application for plugging approved 10-7-53 19.
Plugging commenced 10-8-53 19.
Plugging completed 10-8-53 19.
Reason for abandonment of well or producing formation Dry Hole

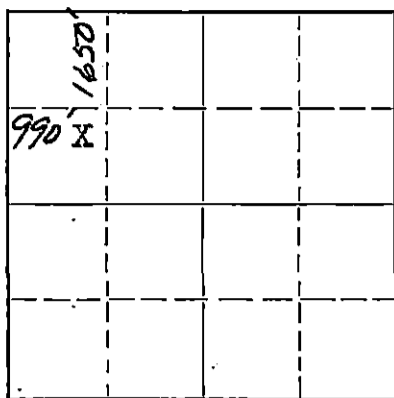

Locate well correctly on above
Section Plat

If a producing well is abandoned, date of last production 19.
Was permission obtained from the Conservation Division or its agents before plugging was commenced? Yes

Name of Conservation Agent who supervised plugging of this well M.A. Rives
Producing formation - Depth to top Bottom Total Depth of Well 5553 Feet
Show depth and thickness of all water, oil and gas formations.

OIL, GAS OR WATER RECORDS

CASING RECORD

Formation	Content	From	To	Size	Put In	Pulled Out
				13 3/8"	505'	None
				8 5/8"	2240'	"

Describe in detail the manner in which the well was plugged, indicating where the mud fluid was placed and the method or methods used in introducing it into the hole. If cement or other plugs were used, state the character of same and depth placed, from feet to feet for each plug set.

Placed a cement plug of 50 sacks at 5553'. Placed a cement plug of 50 sacks from 2425' to 2260'. Squeezed 75 sacks of cement from 2260' to 2249'. Filled with mud laden fluid from 2249' to 500'. Set a cementing plug, 1/2 sack of hulls and 20 sacks of cement at 500'. Filled with mud laden fluid to 35'. Set a cementing plug, 1/2 sack of hulls and 10 sacks of cement from 35' to surface.

RECEIVED
STATE CORPORATION COMMISSION
OCT 15 1953
10-15-53
CONSERVATION DIVISION

Name of Plugging Contractor J.M. Huber Corp.
Address Box 978 Liberal, Kansas

STATE OF KANSAS COUNTY OF SEWARD, ss.
R.E. McDaniel (employee of owner) or (operator) of the above-described well,
being first duly sworn on oath, says: That I have knowledge of the facts, statements, and matters herein contained and the log of the above-described well as filed and that the same are true and correct. So help me God.

(Signature) R.E. McDaniel
Box 978 Liberal, Kansas (Address)

SUBSCRIBED AND SWORN to before me this 13 day of October, 1953
Notary Public.

My commission expires July 27, 1957
23-8390-s 6-51-20M

PLUGGING
FILE SEC 18 T 31 R 40 W
BOOK PAGE 135 LINE 22

15-129-00125-00-00

WELL LOG

Well Name: J.M. Huber Corp. #1 Breeding
Well Location: Cen. NE SW NW Sec. 18, Twp 31, Rge 40W
Morton Co., Kansas
Date Commenced: 8-10-53
Date Completed: 10-8-53
Total Depth: 5553'
Character of Well: Dry Hole

<u>FORMATION</u>	<u>DEPTH</u>
Surface clay and sand	0-125'
Shale, shells and sand	125-473'
Red bed	473-1080'
Red bed and shale	1080-1860'
Shale and shells	1860-2490'
Lime and shale	2490-2685'
Lime	2685-2760'
Lime and shale	2760-5553'
Total Depth	5553'

STATE OF KANSAS, COUNTY OF SEWARD, SS

I, R.E. McDaniel of the J.M. Huber Corp., being first duly sworn on oath, state: That I have knowledge of the facts, statements and matters herein contained and that the same are true and correct.

R.E. McDaniel

Subscribed and sworn to before me this 13 day of October 1953

My Commission Expires:

7-27-57

J. R. Kuyler
Notary Public

PLUGGING
FILE SEC 18 T 31 R 40 W
BOOK PAGE 135 LINE 27