


STATE OF KANSAS
STATE CORPORATION COMMISSION

6-129-20503-0000

WELL PLUGGING RECORD

Give All Information Completely
Make Required Affidavit
Mail or Deliver Report to
Conservation Division
State Corporation Comm.
245 North Water
Wichita, KS 67202

Morton County, Sec. 21 Twp. 31S Rge. 40W
Location as "NE/CNW $\frac{1}{4}$ SW $\frac{1}{4}$ " or footage from lines
C SW/4, NE/4 or 1980' FNL & 1980' FEL
Lease Owner Amoco Production Company
Lease Name P. A. Williams Well No. 2
Office Address P.O. Box 432, Liberal, KS 67901
Character of Well (Completed as Oil, Gas or Dry Hole)
Dry Hole
Date Well completed 3-28 19 81
Application for plugging filed Verbal 3-28 19 81
Application for plugging approved Verbal 3-28 19 81
Plugging commenced 3-28 19 81
Plugging completed 3-28 19 81

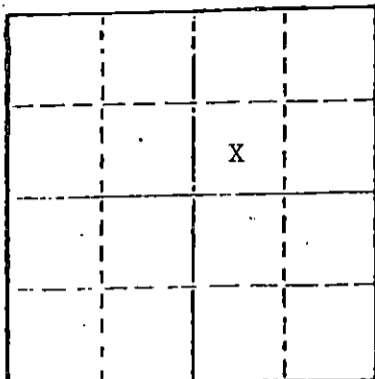

Reason for abandonment of well or producing formation
No oil or gas in commercial quantities.
If a producing well is abandoned, date of last production 19

Was permission obtained from the Conservation Division or its agents before plugging was commenced? Yes

Name of Conservation Agent who supervised plugging of this well Marion Schmidt
Producing formation None Depth to top Bottom Total Depth of Well 5250
Show depth and thickness of all water, oil and gas formations.

OIL, GAS OR WATER RECORDS

CASING RECORD

FORMATION	CONTENT	FROM	TO	SIZE	PUT IN	PULLED OUT
	Sand	0	1558	8.625	1558	0
Toronto		3596	3636			
Missourrian		3636	4334			
Des Moines		4334	4982			
Upper Morrow		4982	5250			

Describe in detail the manner in which the well was plugged, indicating where the mud fluid was placed and the method or methods used in introducing it into the hold. If cement or other plugs were used, state the character of same and depth placed, from feet to feet for each plug set. Set 25 sx cement plug at 2564', set 25 sx cement plug at 2204', set 60 sx cement plug at 1560', set 30 sx cement plug at 480'. Push rubber plug down at 40 feet and set 10 sx cement plug to surface. Cut surface casing 4' below ground level, weld on steel cap and fill with dirt.

(If additional description is necessary, use BACK of this sheet)

Name of Plugging Contractor Service Drilling Company


STATE OF Kansas COUNTY OF Seward, ss.
R. C. Carlson (employee of owner) or (owner or operator)
of the above-described well, being first duly sworn on oath, says: That I have knowledge of the facts, statements, and matters herein contained and the log of the above-described well as filed and that the same are true and correct. So help me God.

(Signature) R. C. Carlson R. C. Carlson
P.O. Box 432, Liberal, KS 67901
(Address)

SUBSCRIBED AND SWORN TO before me this 27th day of April, 1981

[Signature]
Notary Public.

My commission expires 2-2-85

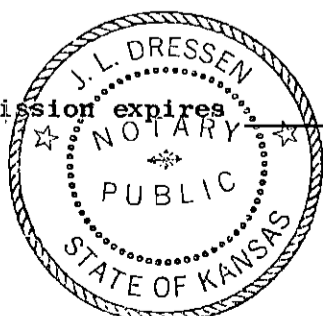

RECEIVED
STATE CORPORATION COMMISSION
4-29-81
APR 29 1981
CONSERVATION DIVISION
Wichita, Kansas