


STATE OF KANSAS
STATE CORPORATION COMMISSION

Give All Information Completely
Make Required Affidavit
Mail or Deliver Report to:
Conservation Division
State Corporation Commission
212 No. Market
Wichita, Kansas

15-129-00073-0000
Form CP-4
WELL PLUGGING RECORD

NORTH

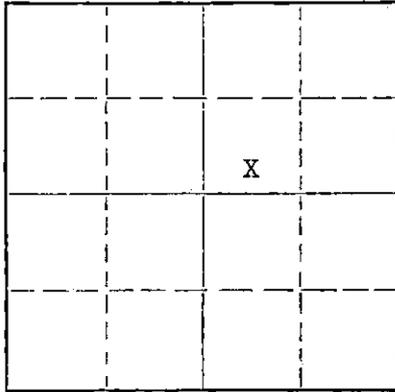

Locate well correctly on above
Section Plat

Morton County, Sec. 22 Twp. 31S Rge. (E) 40 (W)

Location as "NE/CNW/SW" or footage from lines SW NE
Lease Owner Pan American Petroleum Corporation
Lease Name Wratil Gas Unit "B" Well No. 1
Office Address P. O. Box 432 - Liberal, Kansas 67901
Character of Well (completed as Oil, Gas or Dry Hole) Gas
Date well completed 9-12 1960
Application for plugging filed 10-24 1969
Application for plugging approved 10-27 1969
Plugging commenced 11-18 1969
Plugging completed 11-22 1969
Reason for abandonment of well or producing formation depleted to economic limit.

If a producing well is abandoned, date of last production 11-17 1969
Was permission obtained from the Conservation Division or its agents before plugging was commenced? Yes

Name of Conservation Agent who supervised plugging of this well E. Eves
Producing formation _____ Depth to top _____ Bottom _____ Total Depth of Well 6085 Feet
Show depth and thickness of all water, oil and gas formations. PBD 5492

OIL, GAS OR WATER RECORDS

CASING RECORD

| FORMATION | CONTENT | FROM | TO | SIZE | PUT IN | PULLED OUT |
|-----------|---------|------|------|--------|--------|------------|
| Morrow | Gas | 5432 | 5436 | 8-5/8" | 1722 | None |
| | | 5502 | 5504 | 5-1/2" | 6058 | 2688 |
| | | | | | | |
| | | | | | | |
| | | | | | | |
| | | | | | | |

Describe in detail the manner in which the well was plugged, indicating where the mud fluid was placed and the method or methods used in introducing it into the hole. If cement or other plugs were used, state the character of same and depth placed, from _____ feet to _____ feet for each plug set.

Spotted 20 Sx. cement plug from 1743-1693.
Spotted 35 Sx. cement plug from 800- 700.
Spotted 15 Sx. cement plug from 50- 5.
Cut off surface casing 3' below ground level
and welded steel cap on top of casing.

RECEIVED
STATE CORPORATION COMMISSION
DEC 18 1969
CONSERVATION DIVISION
Wichita, Kansas


(If additional description is necessary, use BACK of this sheet)

Name of Plugging Contractor Sargent's Casing Pulling Service
Address P. O. Box 506 - Liberal, Kansas 67901

STATE OF Kansas, COUNTY OF Seward, ss.
J. W. VAUGHN (employee of owner) or (owner or operator) of the above-described well, being first duly sworn on oath, says: That I have knowledge of the facts, statements, and matters herein contained and the log of the above-described well as filed and that the same are true and correct. So help me God.

(Signature) J. W. VAUGHN
P. O. Box 432 - Liberal, Kansas 67901
(Address)

Subscribed and sworn to before me this 15th day of December, 1969.

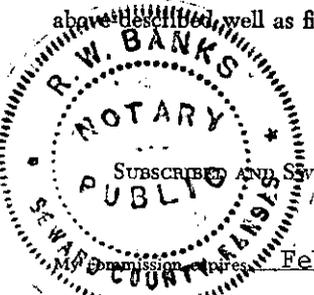

February 11, 1972

Notary Public.

FORMATION RECORD

DESCRIBE EACH FORMATION DRILLED. INDICATE THICKNESS, CONTENT AND WHETHER DRY, OR OIL, GAS, OR WATER BEARING.

| FORMATION | TOP | BOTTOM | FORMATION | TOP | BOTTOM |
|---|------|--------|-----------|-----|--------|
| Clay - Sand | 0 | 103 | | | |
| Sand - Gravel | 103 | 427 | | | |
| Red Sand - Shale | 427 | 996 | | | |
| Anhydrite | 996 | 1152 | | | |
| Anhydrite - Shale | 1152 | 1730 | | | |
| Shale | 1730 | 2261 | | | |
| Anhydrite - Shale | 2261 | 2656 | | | |
| Anhydrite - Shale - Limestone | 2656 | 2870 | | | |
| Shale - Limestone | 2870 | 3096 | | | |
| Limestone | 3096 | 3710 | | | |
| Limestone - Shale | 3710 | 3748 | | | |
| Limestone | 3748 | 3800 | | | |
| Limestone - Shale | 3800 | 3863 | | | |
| Limestone | 3863 | 3875 | | | |
| Limestone - Shale | 3875 | 4390 | | | |
| Limestone | 4390 | 4640 | | | |
| Limestone - Shale | 4640 | 5587 | | | |
| Limestone | 5587 | 5637 | | | |
| Limestone - Shale | 5637 | 5850 | | | |
| Cherty Limestone - Shale | 5850 | 5748 | | | |
| Limestone - Shale | 5748 | 5831 | | | |
| Limestone | 5831 | 5864 | | | |
| Limestone - Shale | 5864 | 6013 | | | |
| Limestone - Chert | 6013 | 6078 | | | |
| Shale - Limestone | 6078 | 6035 | | | |
| Total Depth | | 6035 | | | |
| Plug Back Depth | | 5402 | | | |
| Pan American Completion Record Attached | | | | | |

