


WELL PLUGGING RECORD

Give All Information Completely
Make Required Affidavit
Mail or Deliver Report to:
Conservation Division
State Corporation Commission
211 No. Broadway
Wichita, Kansas

Morton County. Sec. 27 Twp. 31 Rge. 40 ~~(W)~~ (W)
Location as "NE/CNW/SW" or footage from lines C SW/4 NE/4
Lease Owner Pan American Petroleum Corporation
Lease Name Winter Gas Unit "C" Well No. 1
Office Address Box 1654, Oklahoma City, Oklahoma
Character of Well (completed as Oil, Gas or Dry Hole) Gas
Date well completed 12-9 19 60
Application for plugging filed 2-28 19 64
Application for plugging approved 3-3 19 64
Plugging commenced 4-21 19 64
Plugging completed 4-24 19 64
Reason for abandonment of well or producing formation economically depleted

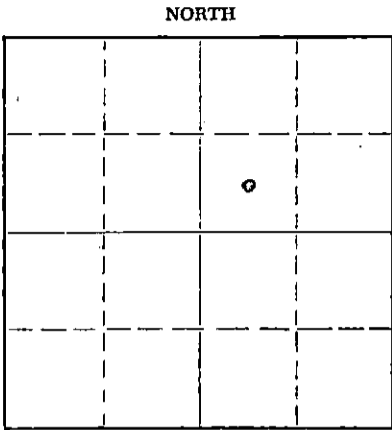

Locate well correctly on above Section Plat

If a producing well is abandoned, date of last production 6-20 19 62
Was permission obtained from the Conservation Division or its agents before plugging was commenced? Yes

Name of Conservation Agent who supervised plugging of this well Hugh Scott
Producing formation Morrow Depth to top 5526 Bottom 5744 Total Depth of Well 6050 Feet
Show depth and thickness of all water, oil and gas formations.

OIL, GAS OR WATER RECORDS

CASING RECORD

FORMATION	CONTENT	FROM	TO	SIZE	PUT IN	PULLED OUT
<u>Morrow</u>	<u>Gas</u>	<u>5526</u>	<u>5744</u>	<u>8 5/8</u>	<u>700</u>	<u>None</u>
	<u>Depleted</u>			<u>5 1/2</u>	<u>6086</u>	<u>2725</u>

Describe in detail the manner in which the well was plugged, indicating where the mud fluid was placed and the method or methods used in introducing it into the hole. If cement or other plugs were used, state the character of same and depth placed, from _____ feet to _____ feet for each plug set.

Pushed plug to 5500
Dumped sand 5500-5480
10 SX cement 5480-5450
Hvy mud 5450-600
35 SX cement 600-514
Hvy mud to 514-55
15 SX cement 55 to surface

RECEIVED
STATE CORPORATION COMMISSION

MAY 12 1964
5-12-64
CONSERVATION DIVISION
Wichita, Kansas

(If additional description is necessary, use BACK of this sheet)
Name of Plugging Contractor Knight Casing Pulling Company
Address Chase, Kansas

STATE OF Kansas, COUNTY OF Seward, ss.
I, D. M. Liles (employee of owner) or (owner or operator) of the above-described well, being first duly sworn on oath, says: That I have knowledge of the facts, statements, and matters herein contained and the log of the above-described well as filed and that the same are true and correct. So help me God.

(Signature) [Signature]
Box 432, Liberal, Kansas
(Address)

SUBSCRIBED AND SWORN TO before me this 8th day of May, 19 64

My commission expires February 11, 1968
R. W. BANKS Notary Public.

FORMATION RECORD

15-129-10140-0000

DESCRIBE EACH FORMATION DRILLED. INDICATE THICKNESS, CONTENT AND WHETHER DRY, OR OIL, GAS, OR WATER BEARING

FORMATION	TOP	BOTTOM	FORMATION	TOP	BOTTOM
Surface Clay, Sand	0	215			
Sand	215	610			
Red Bed, Shale	610	740			
Red Bed	740	1218			
Shale, Anhydrite	1218	1745			
Lime, Shale	1745	2860			
Lime	2860	2926			
Lime, Shale	2926	3018			
Lime	3018	3088			
Lime, Shale	3088	3275			
Lime, Sand	3275	3373			
Lime, Shale	3373	3422			
Lime	3422	3435			
Lime, Shale	3435	3535			
Lime	3535	3635			
Lime, Shale	3635	3705			
Lime	3705	3865			
Lime, Shale	3865	3935			
Lime	3935	4115			
Lime, Shale	4115	4238			
Lime	4238	4400			
Lime, Shale	4400	4615			
Lime	4615	4835			
Lime, Shale	4835	5392			
Shale	5392	5500			
Shale, Lime, Sand	5500	5660			
Lime, Shale	5660	5746			
Lime	5746	6050			
TOTAL DEPTH		6050			
PLUG BACK DEPTH		5610			