

STATE OF KANSAS
STATE CORPORATION COMMISSION

15-129-10177-0000
WELL PLUGGING RECORD

Give All Information Completely
Make Required Affidavit
Mail or Deliver Report to:
Conservation Division
State Corporation Commission
211 No. Broadway
Wichita, Kansas

Morton County, Sec. 6 Twp. 31S Rge. 42 (E) W (24E)

Location as "NE/CNW/SW" or footage from lines 330' fr. E. line & 660' fr. W. line

Lease Owner Rip C. Underwood

Lease Name Kansas University Unit Well No. 1

Office Address 553 First Nat. Bnk. Bldg., Amarillo, Texas

Character of Well (completed as Oil, Gas or Dry Hole) Dry Hole

Date well completed May 28, 19 57

Application for plugging filed (By telephone) May 28, 19 57

Application for plugging approved _____ 19 _____


Plugging commenced May 28, 19 57

Plugging completed May 28, 19 57

Reason for abandonment of well or producing formation Dry Hole

If a producing well is abandoned, date of last production _____ 19 _____

Was permission obtained from the Conservation Division or its agents before plugging was commenced? Yes

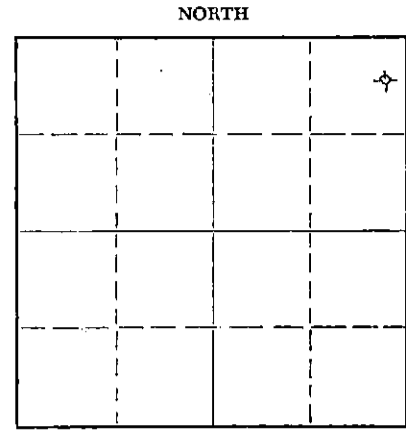

Locate well correctly on above Section Plat

Name of Conservation Agent who supervised plugging of this well M. A. Rives

Producing formation Morrow Depth to top 5250 Bottom 5426 Total Depth of Well 5456 Feet

Show depth and thickness of all water, oil and gas formations.

OIL, GAS OR WATER RECORDS

CASING RECORD

FORMATION	CONTENT	FROM	TO	SIZE	PUT IN	PULLED OUT
Surface Clay & Sand Water			555'	8-5/8" 24#	1497'	None-Cement Circulated

Describe in detail the manner in which the well was plugged, indicating where the mud fluid was placed and the method or methods used in introducing it into the hole. If cement or other plugs were used, state the character of same and depth placed, from _____ feet to _____ feet for each plug set.

Heavy mud placed from 5456' to 600'; set Halliburton plug at 600' and Halliburton pumped 35 sacks cement on top of this plug; set another Halliburton plug on top of heavy mud at 35' and spotted 15 sacks cement from 35' to top of hole.

(If additional description is necessary, use BACK of this sheet)

Name of Plugging Contractor H. & H. DRILLING CO. (using Halliburton equipment)

Address P. O. Box 54, Wichita 1, Kansas

STATE OF Texas, COUNTY OF Potter, ss. H. D. Thompson

(employee of owner) or (owner/operator) of the above-described well, being first duly sworn on oath, says: That I have knowledge of the facts, statements, and matters herein contained and the log of the above-described well as filed and that the same are true and correct. So help me God.

(Signature) H. D. Thompson

553 First National Bnk. Bldg., Amarillo, Texas
(Address)

SUBSCRIBED AND SWORN TO before me this 3rd day of June, 19 57

Mary R. E. [Signature]
Notary Public.

My commission expires June 1, 1958

PLUGGING
FILE SEC 6 T 31 42W
BOOK PAGE 17 LINE 4

6-5-57

CONSERVATION DIVISION
Wichita, Kansas

RIP C. UNDERWOOD - KANSAS UNIVERSITY UNIT NO. 1,
 330' from E. Line and 660' from N. Line of
 Section 6, T 31S, R 42W, Morton County, Kansas.

15-129-10177-1000

Clay	0	35
Shale & Clay	35	173
Shale, Shells & Streaks of Sand	173	555
Red Bed & Iron Pyrites	555	755
Anhydrite, Red Bed & Pyrite	755	970
Red Bed & Lime Streaks	970	1498
Anhydrite	1498	1540
Shale & Lime	1540	1900
Anhydrite, Shale & Lime	1900	2015
Broken Anhyd. & Sand Streaks	2015	2275
Shale & Lime	2275	2595
Shale, Sand & Anhyd.	2595	2862
Limey Sand w/Shale Streaks	2862	2900
Shale	2900	3310
Lime & Shale	3310	3400
Lime & Shale	3400	3514
Lime & Shale	3514	3586
Lime & Shale	3586	3685
Shale & Lime	3685	3930
Sandy Lime	3930	3960
Shale w/Lime Streaks	3960	4210
Lime	4210	4656
Lime & Shale	4656	4803
Shale	4803	5250
Sand	5250	5426
Lime	5426	5456 TD

Tops:

Wabaunsee	2862
Topeka	3310
LeCompton	3514
Heeb.	3546
Tor.	3586
Lansing	3685
Marmaton	4210
Morrow Shale	4803
F Zone	5250
Keyes	5263
G Zone	5310
Miss.	5426

RECEIVED
 STATE CORPORATION COMMISSION
 JUN 5 X 1957
 CONSERVATION DIVISION
 Wichita, Kansas

PLUGGING	
FILE	SEC 6 T 31 R 42W
BOOK	PAGE 17 LINE 4