15-129-20756-0000

STATE OF KANSAS
STATE CORPORATION COMMISSION

Give All Information Completely
Make Required Affidavit
Mail or Deliver Report to:
Conservation Division
State Corporation Commission
P. O. Box 17027
Wichita, Kansas 67217

Form CP-4

WELL PLUGGING RECORD

NORTH

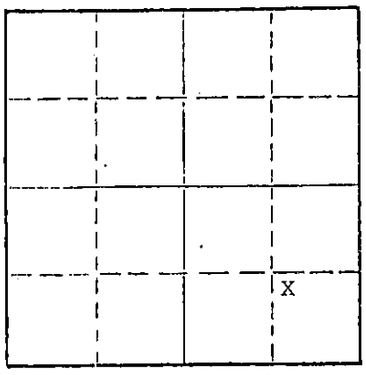

Locate well correctly on above Section Plat

Morton County. Sec. 2 Twp. 31S Rge. ___ (E) 41 (W)

Location as "NE/CNW¼SW¼" or footage from lines 1,250' FSL & 1,250 FEL

Lease Owner Charles B. Wilson, Jr., Inc.

Lease Name Jean Donaghy Well No. 1-2

Office Address 1616 West Loop South, Suite 310, Houston, Texas 77027

Character of Well (completed as Oil, Gas or Dry Hole) Dry Hole

Date well completed May 11 19 85

Application for plugging filed (Verbal) May 11, 19 85

Application for plugging approved May 11 19 85

Plugging commenced May 11 19 85

Plugging completed May 11 19 85

Reason for abandonment of well or producing formation Wet

If a producing well is abandoned, date of last production ___ 19___

Was permission obtained from the Conservation Division or its agents before plugging was commenced? Yes

Name of Conservation Agent who supervised plugging of this well NA

Producing formation Winfield (Wet) Depth to top 2,260' Bottom 2,280' Total Depth of Well 2,350 Feet

Show depth and thickness of all water, oil and gas formations.

OIL, GAS OR WATER RECORDS — CASING RECORD

FORMATION	CONTENT	FROM	TO	SIZE	PUT IN	PULLED OUT
Chase	Water	2,226	2,350	-	-	-
Surface SDS	Water	0	450	8 5/8	640	None

Describe in detail the manner in which the well was plugged, indicating where the mud fluid was placed and the method or methods used in introducing it into the hole. If cement or other plugs were used, state the character of same and depth placed, from ___ feet to ___ feet for each plug set.

50 sax plug circulated from 1,320 to 1,170'
50 sax plug curculated from 660 to 510' (bottom surf. csg.)
10 sax plug circulated from 40 to Surface
15 sax plug filled rat hole.

RECEIVED
STATE CORPORATION COMMISSION
JUN 07 1985
CONSERVATION DIVISION
Wichita, Kansas

(If additional description is necessary, use BACK of this sheet)

Name of Plugging Contractor Dowell Inc.

Address Ulysses, Kansas

STATE OF Texas, COUNTY OF Harris, ss.

Charles B. Wilson, Jr. (employee of owner) or (owner or operator) of the above-described well, being first duly sworn on oath, says: That I have knowledge of the facts, statements, and matters herein contained and the log of the above-described well as filed and that the same are true and correct. So help me God.

(Signature) Charles B. Wilson Jr.

1616 West Loop South, Suite 310, Houston, Texas 77027
(Address)

SUBSCRIBED AND SWORN TO before me this 14th day of May, 19 85

Gladys J. Taylor
Notary Public.

My commission expires

GLADYS J. TAYLOR
Notary Public State of Texas
My Commission Expires July 16, 1985
Bonded by L. Alexander Lovett, Lawyers Surety Corp.