


WELL PLUGGING RECORD

Give All Information Completely  
Make Required Affidavit  
Mail or Deliver Report to:  
Conservation Division  
State Corporation Commission  
211 No. Broadway  
Wichita, Kansas

Morton County. Sec. 8 Twp. 31 S Rge. 42 (X) W (W)  
Location as "NE/CNW%SW%" or footage from lines Ctr. NE  
Lease Owner Rupp-Ferguson Oil Company  
Lease Name Kansas University Well No. 1  
Office Address 522 Union Center, Wichita, Kansas  
Character of Well (completed as Oil, Gas or Dry Hole) Dry Hole  
Date well completed March 4, 1957  
Application for plugging filed March 4 - Phone 1957  
Application for plugging approved March 4 - Phone 1957  
Plugging commenced March 4, 1957  
Plugging completed March 4, 1957  
Reason for abandonment of well or producing formation Dry Hole

NORTH

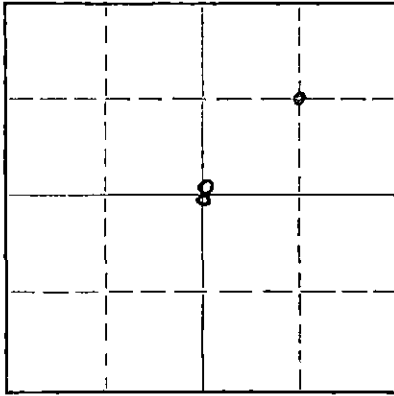

Locate well correctly on above Section Plat

If a producing well is abandoned, date of last production 19  
Was permission obtained from the Conservation Division or its agents before plugging was commenced? Yes

Name of Conservation Agent who supervised plugging of this well M. A. Rives, Pratt, Kansas  
Producing formation \_\_\_\_\_ Depth to top \_\_\_\_\_ Bottom \_\_\_\_\_ Total Depth of Well 5498 <sup>KB</sup> Feet  
Show depth and thickness of all water, oil and gas formations.

OIL, GAS OR WATER RECORDS

CASING RECORD

FORMATION	CONTENT	FROM	TO	SIZE	PUT IN	PULLED OUT
<u>Sand, Clay and Shale</u>						
<u>Red Gyp. and Anhydrite</u>		<u>0'</u>	<u>1516'</u>	<u>8-5/8"</u>	<u>1516'</u>	<u>None</u>

Describe in detail the manner in which the well was plugged, indicating where the mud fluid was placed and the method or methods used in introducing it into the hole. If cement or other plugs were used, state the character of same and depth placed, from \_\_\_\_\_ feet to \_\_\_\_\_ feet for each plug set.

Filled hole with heavy rotary mud from 5498' to 671'. Set plug @ 670' w/ 35 sx. cement through open-end drill pipe, filled hole with rotary mud from 671' to 40'. Set top plug @ 40', cemented with 15 sx. through open-end drill pipe. Plugging completed.

RECEIVED  
STATE CORPORATION COMMISSION

MAR 12 1957 3-12-57

CONSERVATION DIVISION  
Wichita, Kansas

(If additional description is necessary, use BACK of this sheet)

Name of Plugging Contractor The R. W. Rine Drilling Company  
Address 420 Union Center, Wichita, Kansas

STATE OF KANSAS COUNTY OF SEDGWICK, ss. E. H. SLOYER agent for operator  
(employee of owner) or (owner or operator) of the above-described well, being first duly sworn on oath, says: That I have knowledge of the facts, statements, and matters herein contained and the log of the above-described well as filed and that the same are true and correct. So help me God.

(Signature) RUPP-FERGUSON OIL COMPANY  
BY E. H. Sloyer (Address) Agent for Operator

SUBSCRIBED AND SWORN TO before me this 8th day of March, 1957.

My commission expires July 9, 1960.

Edna Landry  
Notary Public.

PLUGGING  
FILE SEC 8 T. 31 R. 42W  
BOOK PAGE 145 LINE 3

CONTRACTOR: THE R. W. RINE DRILLING CO.

15-129-00045-0000

STARTED: FEBRUARY 11, 1957

COMPLETED: MARCH 4, 1957

LOG

SAND & CLAY	0'	75'		
SHALE	75'	300'	SYFO @ 170'	3/4° , @ 270' 1/2°
RED BED & SHALE	300'	755'	SYFO @ 450'	1/2° , @ 635' 1/4°
			SYFO @ 730'	1/2°
SAND & SHALE	755'	1070'	SYFO @ 880'	3/4°
GYP	1070'	1140'	SYFO @ 1100'	1/2°
GYP & SHALE	1140'	1355'	SYFO @ 1295'	3/4°
CLAY, SHALE & ANHYDRITE	1355'	1518'	SYFO @ 1515'	3/4°
			8 5/8" CSG @ 1516'	w/825 sx.
SHALE & SHELLS	1518'	2150'	SYFO @ 1680'	1/2° , @ 1955' 3/4°
SAND, SHALE & SHELLS	2150'	2385'	SYFO @ 2230'	1/2°
LIME & SHALE	2385'	2660'	SYFO @ 2470'	1/2°
LIME	2660'	2750'	SYFO 2650'	1/2°
LIME & SHALE	2750'	2870'		
LIME	2870'	3600'	SYFO @ 2975'	1° , @ 3185' 3/4°
			SYFO @ 3450'	1° @ 3530' 1/2°
LIME & SHALE	3600'	3855'	SYFO @ 3730'	1 1/2°
LIME	3855'	4055'	SYFO @ 3980'	2 3/4° , @ 4050' 1 3/4°
LIME & SHALE	4055'	4250'	SYFO @ 4205'	1 1/4°
LIME	4250'	4434'	SYFO @ 4330'	1 1/4° @ 4430' 3/4°
LIME & SHALE	4434'	4938'	SYFO @ 4550'	3/4° , @ 4715' 1/2°
			SYFO @ 4810'	1/2° , @ 4935' 1/2°
SHALE	4938'	5249'	SYFO @ 5125'	3/4°
SAND & SHALE	5249'	5277'	SYFO @ 5265'	1/2°
LIME & SHALE	5277'	5294'		
SAND & LIME	5294'	5330'		
LIME	5330'	5370'		
LIME, SHALE & SAND	5370'	5398'		
LIME	5398'	5498'		

RECEIVED  
 STATE CORPORATION COMMISSION

MAR 12 1957

CONSERVATION DIVISION  
 Wichita, Kansas

SYFO @ 5490' STATE CORPORATION COMMISSION  
 D. & A.

STATE OF KANSAS: COUNTY OF SEDGWICK: ss

I, E. H. SLOYER, DO HEREBY CERTIFY THAT THE ABOVE IS A TRUE AND ACCURATE LOG OF THE KANSAS UNIVERSITY WELL No. 1, LOCATED C NE, SECTION 8-31S-42W, MORTON COUNTY, KANSAS.

*E. H. Sloyer*  
 SECRETARY-TREASURER

SUBSCRIBED TO AND SWORN BEFORE ME THIS 7TH DAY OF MARCH, 1957.

*[Signature]*

PLUGGING Notary Public  
 FILE SEC. 8 T. 31 R. 42W  
 BOOK PAGE 145 LINE 3

MY COMMISSION EXPIRES: 6-14-58.