


15-175-60443-0000

WELL PLUGGING RECORD

Give All Information Completely  
 Make Required Affidavit

COUNTY Seward SEC. 18 TWP. 31S RGE. 32 W/W  
 Location as in quarters or footage from lines:  
1320 ENL x 2590 FEL

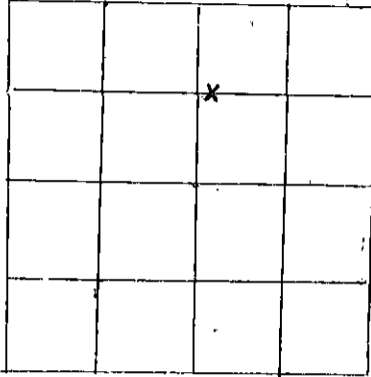

Locate Well  
 correctly on above  
 Section Platt.

Lease Owner Amoco Production Company  
 Lease Name Lower Gas Unit Well No. 1  
 Office Address P. O. Box 432 Liberal, KS 67901  
 Character of Well (Completed as Oil, Gas or Dry Hole): Gas  
 Date Well Completed December 12, 1954  
 Application for plugging filed October 10, 1983  
 Plugging commenced October 24, 1983  
 Plugging completed October 25, 1983  
 Reason for abandonment of well or producing formation Casing  
leak filled wellbore with sand  
 Was permission obtained from the Conservation Division or it's  
 Agent's before plugging was commenced? Yes

Name of Conservation Agent who supervised plugging of this well Dodge City Office  
 Producing formation Hugoton Depth to top 2604 bottom 2106 T.D. 2706  
 Show depth and thickness of all water, oil and gas formations.

OIL, GAS OR WATER RECORDS

Casing Record

Formation	Content	From	To	Size	Put in	Pulled Out
Hugoton	Gas	2604	2706	8-5/8	578	0
				5-1/2	2681	0

Describe in detail the manner in which the well was plugged, indicating where the mud fluid was placed and the method or methods used in introducing it into the hold. If cement or other plugs were used, state the character of same and depth placed, from \_\_\_\_\_ feet to \_\_\_\_\_ feet for each plug set.

1. Spot 35 sacks of cement, through tubing, on top of the sand fill (tagged at 2100')
2. Load the hole with 9.0 PPG mud and circulate the bottoms up prior to cementing.
3. Spot 20 sacks of cement from 1700' to 1550' through tubing.
4. Spot 25 sacks of cement from 630' to 530' through tubing.
5. Spot 12 sacks of cement, with one joint of tubing in the hole from 40' to 5' through tubing. Check by visual inspection.
6. Cut off surface casing 5' below ground level, weld on a steel cap, and fill the hole with dirt.


The procedure detailed above has placed a cement cap on the sand fill, a cement plug in the interval of the casing leak, a cement plug at the end of the surface casing, & a cement plug at the surface. An inspection of the logs for this well did not reveal any anhydrite intervals (If additional description is necessary, use BACK of this sheet) (over)

Name of Plugging Contractor Midwest Casing Pullers

STATE OF Kansas COUNTY OF Seward, ss.  
T. A. Powers (employee of owner) or (owner or operator) of the  
 above-described well, being first duly sworn on oath, says: That I have knowledge of the  
 facts, statements, and matters herein contained and the log of the above-described well as  
 filed and that the same are true and correct. So help me God.

(Signature) T.A. Powers  
P. O. Box 432 Liberal, KS 67901  
 (Address)

SUBSCRIBED AND SWORN TO before me this 18th day of January, 19 84

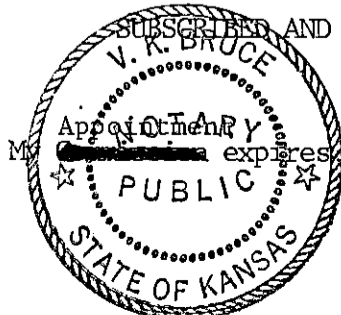

V. K. Bruce  
 Notary Public.

RECEIVED  
 STATE CORPORATION COMMISSION

JAN 20 1984

CONSERVATION DIVISION  
 Wichita, Kansas

