


STATE OF KANSAS
 STATE CORPORATION COMMISSION

Give All Information Completely
 Make Required Affidavit
 Mail or Deliver Report to:
 Conservation Division
 State Corporation Commission
 800 Bittling Building
 Wichita, Kansas

OR
FORMATION PLUGGING RECORD

Strike out upper line
 when reporting plug-
 ging off formations.

NORTH

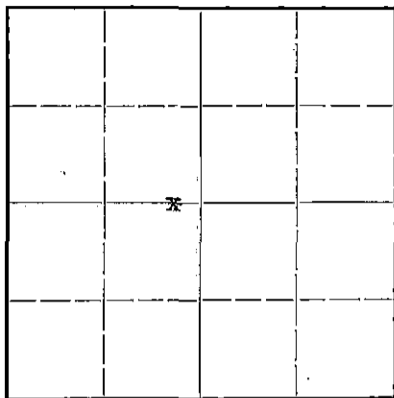

Locate well correctly on above
 Section Plat

Seward County. Sec. 23 Twp. 31S Rge. (E) 32 (W)
 Location as "NE1/4NW1/4SW1/4" or footage from lines. 50' West of Center
 Lease Owner. The Carter Oil Co.
 Lease Name. E. Chapple Well No. 1
 Office Address. Box 786, Great Bend, Kansas
 Character of Well (completed as Oil, Gas or Dry Hole) Dry Hole
 Date well completed. 5-16 19 45
 Application for plugging filed. 5-16 19 45
 Application for plugging approved. 5-18 19 45
 Plugging commenced. 5-16 19 45
 Plugging completed. 5-16 19 45
 Reason for abandonment of well or producing formation Dry Hole

If a producing well is abandoned, date of last production. 19
 Was permission obtained from the Conservation Division or its agents before plugging was com-
 menced? Yes

Name of Conservation Agent who supervised plugging of this well. H. W. Kerr
 Producing formation. Depth to top. Bottom. Total Depth of Well. 2890 Feet
 Show depth and thickness of all water, oil and gas formations.

OIL, GAS OR WATER RECORDS

CASING RECORD

Formation	Content	From	To	Size	Put In	Pulled Out
				10 3/4"	482'	0

Describe in detail the manner in which the well was plugged, indicating where the mud fluid was placed and the method or methods used in introducing it into the hold. If cement or other plugs were used, state the character of same and depth placed, from feet to feet for each plug set.

Heavy Mud 2890' - 450'
 Cement 450' - 410'
 Heavy Mud 410' - 20'
 Cement 20' - Surface


(If additional description is necessary, use BACK of this sheet)

Correspondence regarding this well should be addressed to The Carter Oil Company
 Address. Box 786, Great Bend, Kansas

STATE OF Kansas, COUNTY OF Barton, ss.
 E. A. Rose (employee of owner) or (owner or operator) of the above-described well,
 being first duly sworn on oath, says: That I have knowledge of the facts, statements, and matters herein contained and the log of the above-described well as filed and that the same are true and correct. So help me God.

(Signature) E. A. Rose Prod. Supt.
 Box 786, Great Bend, Kansas (Address)

SUBSCRIBED AND SWORN to before me this 19 day of July, 1945
 My Commission Expires July 29, 1946
 Notary Public.

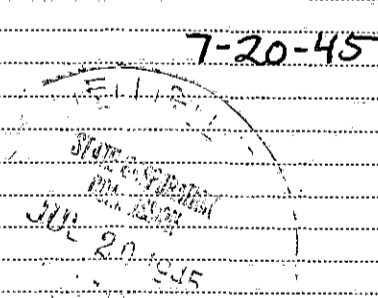

23 31 32W
 18 10

DRILLER'S LOG

15-175-0000-0000

Company: The Carter Oil Company
 Farm: #1 E. Chapple

Sec. 23 T. 31s R. 32w
 CE/2 E/2 W/2
 50' W of Center of Section

Total Depth: 2890'
 Comm. 4-19-45 Comp. 5-16-45
 Issued 6-23-45

County: Seward County, Kansas

Casing: 10 3/4" 489'

Production: Dry

Surface soil	0-160
sand, lime, shells, shale	408
red bed	590
red bed & shale	1060
anhydrite & red bed	1160
sand red	1360
red bed & shells	1690
anhydrite	1780
red bed & shell	1935
lime & strks. red bed	2005
lime & shale	2190
lime strks, shale	2245
lime & shale	2345
anhydrite & shale	2395
lime	2552
lime & anhydrite	2582
lime	2615
lime & shale	2652
lime	2817
lime & shale	2890
Total Depth	

Tops:

Blaine	1035
Cedar Hill	1240
Anhydrite	1715
Hollenberg	2572
Herrington	2603
Lower Herrington	2640
Krider	2656
Winfield	2724
Ft. Riley	2765
Florence Flint	2855

RECORDED
 JUN 6 X 1950
 STATE OF KANSAS
 COMMISSIONER
 OF GAS