


15-175-00449-0000

STATE OF KANSAS
STATE CORPORATION COMMISSION

Give All Information Completely
Make Required Affidavit
Mail or Deliver Report to:
Conservation Division
State Corporation Commission
P. O. Box 17027
Wichita, Kansas 67217
NORTH

WELL PLUGGING RECORD

Seward County, Sec. 24 Twp. 31S Rge. 11E 32 (W)
Location as "NE/CNW&SW" or footage from lines C NW
Lease Owner Graham-Michaelis Corporation
Lease Name Rosson Well No. 1
Office Address P. O. Box 247, Wichita, Kansas 67201
Character of Well (completed as Oil, Gas or Dry Hole) Gas Well
Date well completed February 7, 1956
Application for plugging filed September 16, 1974
Application for plugging approved September 17, 1974
Plugging commenced September 25, 1974
Plugging completed September 25, 1974
Reason for abandonment of well or producing formation Non Commercial

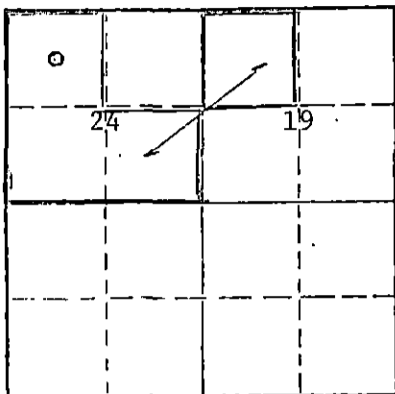

Locate well correctly on above
Section Plat

If a producing well is abandoned, date of last production March 1974
Was permission obtained from the Conservation Division or its agents before plugging was commenced? Yes

Name of Conservation Agent who supervised plugging of this well Clarence Thomas, Garden City, Kansas
Producing formation Hugoton Depth to top 2648 Bottom 2696' Total Depth of Well 2736' Feet
Show depth and thickness of all water, oil and gas formations.

OIL, GAS OR WATER RECORDS

CASING RECORD

FORMATION	CONTENT	FROM	TO	SIZE	PUT IN	PULLED OUT
				8 5/8"	558'	none
				5 1/2"	2733'	1687'

Describe in detail the manner in which the well was plugged, indicating where the mud fluid was placed and the method or methods used in introducing it into the hole. If cement or other plugs were used, state the character of same and depth placed, from _____ feet to _____ feet for each plug set.

cement plug (20 sacks cement) to 2500'
filled with heavy drilling mud
cement plug (35 sacks cement) from 500' to 600'
filled with heavy drilling mud
cement plug (15 sacks cement) from 45' to 0'

RECEIVED
STATE CORPORATION COMMISSION
OCT 8 1974
CONSERVATION DIVISION
Wichita, Kansas

(If additional description is necessary, use BACK of this sheet)

Name of Plugging Contractor Sargent Casing Pulling
Address Box 506, Liberal, Kansas

STATE OF Kansas, COUNTY OF Sedgwick, ss.
Jack L. Yinger (employee of owner) or (owner or operator) of the above-described well, being first duly sworn on oath, says: That I have knowledge of the facts, statements, and matters herein contained and the log of the above-described well as filed and that the same are true and correct. So help me God.

(Signature) Jack L. Yinger
P. O. Box 247, Wichita, Kansas 67201
(Address)

SUBSCRIBED AND SWORN TO before me this 7th day of October, 1974

My commission expires
MURIEL F. C. JERAM
NOTARY PUBLIC
SEDGWICK COUNTY, KANSAS
MY COMMISSION EXPIRES
JULY 25, 1976

Muriel F. C. Jeram
Notary Public.

15-175-00449-00-00

ROSSON #1

Well Record

Location: C/ NW/4 Section 24-31S-32W
Seward County, Kansas

Commenced: Jan. 16, 1956
Completed: Jan. 23, 1956
(rotary)

Operator: Michaelis Drilling Company
1019 East Second Street
Wichita 7, Kansas

Elevation: Est. 2844 DF
2842 Gr

Contractor: Michaelis Drilling Company
1019 East Second Street
Wichita 7, Kansas

15-175-00449-0000

Casing Record: 8-5/8" @ 558' w/300 sacks cement
5-1/2" @ 2733' w/400 sacks cement

LOG

Clay	80
Sand & Clay	433
Yellow Clay	463
Sand	525
Red Bed	559
Red Bed w/streaks of Sand	1100
Red Bed & Gyp	1150
Sand	1370
Red Bed & Shale	1495
Red Bed & Gyp	1870
Red Bed & Anhydrite	2695
Anhydrite & Shale	2736, RTD

RECEIVED
STATE CORPORATION COMMISSION
SEP 17 1954
CONSERVATION DIVISION
Wichita, Kansas

Herrington 2620
Upper Krider 2643
Lower Krider 2680

STATE OF KANSAS)
COUNTY OF SEDGWICK) ss.

The undersigned, MICHAELIS DRILLING COMPANY, hereby certifies that the above log is a true and correct log of the formations encountered in drilling the above well as reflected by the Daily Drilling Report.

MICHAELIS DRILLING COMPANY

By John L. James
John L. James
Geologist.

Subscribed and sworn to before me this
2nd day of February, 1956.

Mary L. Barnes

My commission expires: 11/7/57.

Copy