

15-119-20176-0005


Form CP-4

STATE OF KANSAS  
STATE CORPORATION COMMISSION

Give All Information Completely  
Make Required Affidavit  
Mail or Deliver Report to:  
Conservation Division  
State Corporation Commission

WELL PLUGGING RECORD

P. O. Box 17027  
Wichita, Kansas 67217

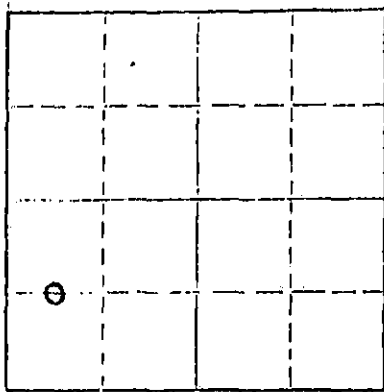

Locate well correctly on above  
Section Plat

Meade County, Sec. 25 Twp 31 Rge. (E) 29 (W)  
Location as "NE/CNWSW" or footage from lines 330' FWL & 660' FSL of SE/4  
Lease Owner Sidwell Oil & Gas, Inc.  
Lease Name Savage #1 Well No. #1  
Office Address P. O. Box 2475, Pampa, Texas 79065  
Character of Well (completed as Oil, Gas or Dry Hole) Dry Hole  
Date well completed 11-22 19 74  
Application for plugging filed 11-22 19 74  
Application for plugging approved 11-22 19 74  
Plugging commenced 11-22 19 74  
Plugging completed 11-22 19 74  
Reason for abandonment of well or producing formation

If a producing well is abandoned, date of last production 19  
Was permission obtained from the Conservation Division or its agents before plugging was commenced? Yes

Name of Conservation Agent who supervised plugging of this well  
Producing formation Depth to top Bottom Total Depth of Well 6048 Feet  
Show depth and thickness of all water, oil and gas formations.

OIL, GAS OR WATER RECORDS

CASING RECORD

FORMATION	CONTENT	FROM	TO	SIZE	PUT IN	PULLED OUT
				8 5/8	1505'	

Describe in detail the manner in which the well was plugged, indicating where the mud fluid was placed and the method or methods used in introducing it into the hole. If cement or other plugs were used, state the character of same and depth placed, from feet to feet for each plug set.

First plug 35 sxs. cement @ 1550-1450  
Second plug 35 sxs cement @ 800-700  
Third plug 15 sxs cement @ 40-0

RECEIVED  
STATE CORPORATION COMMISSION  
NOV 26 1974  
CONSERVATION DIVISION  
Wichita, Kansas

Name of Plugging Contractor (If additional description is necessary, use BACK of this sheet)  
Address

STATE OF Kansas COUNTY OF Sedgwick ss.  
C. Robert Buford (employee of owner) or (owner or operator) of the above-described

well, being first duly sworn on oath, says: That I have knowledge of the facts, statements, and matters herein contained and the log of the above-described well as filed and that the same are true and correct. So help me God.

(Signature) C. Robert Buford  
Suite 600, 200 West Douglas, Wichita, Kansas 67202 (Address)

Subscribed and Sworn to before me this 25th day of November, 1974

My commission expires August 15, 1975 Myrna D. Murphy Notary Public.

WELL LOG

15-119-20176-0005

COMPANY Sidwell Oil & Gas, Inc.

SEC. 25-31S-29W

FARM Savage

NO. #1

LOC. 330' FWL & 660' FSL of SE/4

TOTAL DEPTH 6048'


COUNTY Meade

COMM. 11-6-74

COMP. 11-22-74

CONTRACTOR Zenith Drilling Corporation, Inc.

CASING Rañ/1505' of 8 5/8" casing w/950 sxs cement

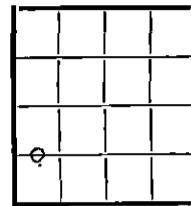

ELEVATION

PRODUCTION D & A

FIGURES INDICATE BOTTOM OF FORMATIONS

0	218	Sand & Clay
218	827	Sand & Redbed
827	1460	Redbed
1460	1520	Anhydrite
1520	1743	Anhydrite & Redbed
1743	3123	Shale & Lime
3123	3222	Shale, Lime & Dolomite
3222	3751	Dolomite
3751	4010	Lime
4010	4423	Lime & Shale
4423	4625	Lime
4625	4710	Lime & Shale
4710	6048	Lime
6048	TD	

RECEIVED  
STATE CORPORATION COMMISSION  
NOV 26 1974  
CONSERVATION DIVISION  
Wichita, Kansas

State of Kansas  
County of Sedgwick } ss

I, C. Robert Buford of Zenith Drilling Corporation, Inc.

upon oath state the above and foregoing is a true and correct copy of the log of the Savage #1 well.

C. Robert Buford

Subscribed and sworn to before me this 25th day of November, 19 74

My Commission Expires: August 15, 1975

Myrna D. Murphy  
Myrna D. Murphy NOTARY PUBLIC