

STATE OF KANSAS  
STATE CORPORATION COMMISSION


WELL PLUGGING RECORD

15-025-2057-0000

Give All Information Completely  
Make Required Affidavit  
Mail or Deliver Report to  
Conservation Division  
State Corporation Comm.  
245 North Water  
Wichita, KS 67202

Clark County, Sec. 3 Twp. 31S Rge. 24W E/W  
Location as "NE/CNW $\frac{1}{4}$ SW $\frac{1}{4}$ " or footage from lines  
NE NE

Lease Owner PICKRELL DRILLING COMPANY  
Lease Name McFadden "C" Well No. 2  
Office Address 205 LITWIN BLDG., WICHITA, KS. 67202  
Character of Well (Completed as Oil, Gas or Dry Hole)

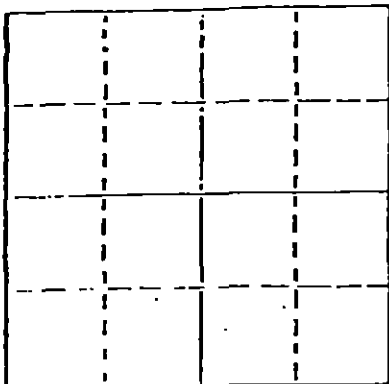

Locate well correctly on above  
Section Plot

DRY HOLE  
Date Well completed 6-21-77 19  
Application for plugging filed 6-21-77 19  
Application for plugging approved 6-21-77 19  
Plugging commenced 6-21-77 19  
Plugging completed 6-21-77 19  
Reason for abandonment of well or producing formation  
DRY HOLE

If a producing well is abandoned, date of last production 19

Was permission obtained from the Conservation Division or  
its agents before plugging was commenced? Yes

Name of Conservation Agent who supervised plugging of this well Clarence Thomas  
Producing formation Depth to top Bottom Total Depth of Well 5595  
Show depth and thickness of all water, oil and gas formations.

OIL, GAS OR WATER RECORDS

CASING RECORD

FORMATION	CONTENT	FROM	TO	SIZE	PUT IN	PULLED OUT
				8 5/8	331	None

Describe in detail the manner in which the well was plugged, indicating where the mud fluid  
was placed and the method or methods used in introducing it into the hold. If cement or other  
plugs were used, state the character of same and depth placed, from feet to  
feet for each plug set.

Plugging Information: 50 sacks at 300'  
15 sacks at 40'  
5 sacks in Rathole  
Comp. 8:45PM 6/21/77

RECEIVED  
JUN 19 1977  
7-19-77  
CONSERVATION DIVISION  
Wichita, Kansas

(If additional description is necessary, use BACK of this sheet)

Name of Plugging Contractor PICKRELL DRILLING COMPANY

STATE OF KANSAS COUNTY OF SEDGWICK, ss.  
C. W. Sebitts (employee of owner) or (owner or operator)

of the above-described well, being first duly sworn on oath, says: That I have knowledge of  
the facts, statements, and matters herein contained and the log of the above-described well  
as filed and that the same are true and correct. So help me God.

BY: C. W. Sebitts  
(Signature) *[Signature]*  
205 Litwin Bldg., Wichita, Ks. 67202  
(Address)

SUBSCRIBED AND SWORN TO before me this 15 day of July, 1977

*[Signature]*  
Jo Ann Sarver  
Notary Public.

My commission expires



**ROTARY DRILLING LOG**

COMPANY: PICKRELL DRILLING COMPANY  
 205 LITWIN BLDG.  
 WICHITA, KS. 67202  
 LOCATION: McFADDEN "C" #2  
 NE NE 3-31S-24W  
 Clark Co., Ks.  
 CONTRACTOR: PICKRELL DRILLING COMPANY  
 Wichita, Kansas

Rotary Drilling Commenced 6-06-77  
 Rotary Drilling Completed 6-21-77  
 15-025-2087-0062

CASING RECORD: Surface casing set at 331' with 250 sacks. Comp. 6/6/77 9:00PM

**LOG**

(Figures indicate bottom of formation — measurements from top of rotary bushing.)

Top Soil & Shale	334
Shale & Redbeds	760
Shale & Redbeds	1630
Shale	2004
Shale & Shells	2144
Shale & Lime Strks	2460
Lime & Shale	2656
Lime & Shale	2791
Lime & Shale	2957
Lime	3100
Lime & Shale	3111
Lime & Shale	3175
Lime & Shale	3321
Lime & Shale	3448
Lime & Shale	3610
Lime & Shale	3745
Lime & Shale	3915
Lime & Shale	4070
Lime & Shale	4200
Lime & Shale	4344
Lime & Shale	4482
Lime & Shale	4600
Lime & Shale	4730
Lime & Shale	4852
Lime & Shale	4980
Lime & Shale	5028
Lime & Shale	5105
Lime & Shale	5169
Lime & Shale	5230
Lime & Shale	5295
Lime & Shale	5354
Lime & Shale	5399
Lime & Shale	5455
Lime	5500
Lime	5546
Lime	5595

RECEIVED  
 STATE COMMISSIONER  
 7-19-77  
 JUL 19 1977  
 CONSERVATION DIVISION  
 Wichita, Kansas

The undersigned, C. W. Sebitts, Attorney-in-Fact for PICKRELL DRILLING COMPANY, hereby certifies in behalf of said Company, that the above is a true and correct log of the formation encountered in drilling the above well as reflected by the Daily Drilling Reports.

PICKRELL DRILLING COMPANY  
 By [Signature]  
 Attorney-in-Fact  
 C. W. Sebitts

STATE OF KANSAS }  
 COUNTY OF SEDGWICK } ss.:

On this 15 day of July, 19 77, before me the undersigned, a Notary Public, in and for

the County and State aforesaid, personally appeared C. W. Sebitts, to me known to be the identical person who subscribed the name of PICKRELL DRILLING COMPANY to the foregoing instrument as its Attorney-in-Fact and acknowledged to me that he executed the same as his free and voluntary act and deed, and as the free and voluntary act and deed of such company, for the uses and purposes therein set forth.

Given under my hand and seal of office the day and year last above written.

My commission expires: \_\_\_\_\_

[Signature]  
 Notary Public  
 Jo Ann Sarver

