


WELL PLUGGING RECORD

Give All Information Completely
Make Required Affidavit
Mail or Deliver Report to:
Conservation Division
State Corporation Commission
211 No. Broadway
Wichita, Kansas

Morton County. Sec. 14 Twp. 31 Rge. 41 (E) (W)
Location as "NE/CNW&SW" or footage from lines C SE NW
Lease Owner Anadarko Production Company
Lease Name Cunningham Well No. 1
Office Address P.O. Box 351, Liberal, Kansas
Character of Well (completed as Oil, Gas or Dry Hole) Gas
Date well completed 5-28 1957
Application for plugging filed 7-13 1964
Application for plugging approved 7-14 1964
Plugging commenced 8-7 1964
Plugging completed 8-7 1964
Reason for abandonment of well or producing formation depleted

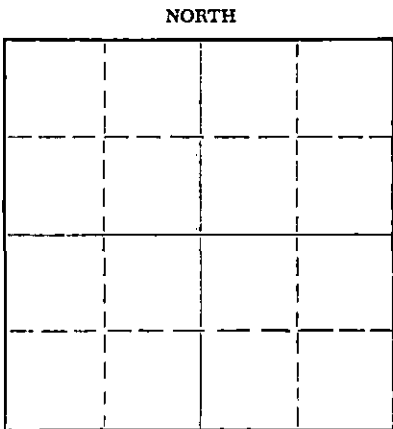

Locate well correctly on above Section Plat

If a producing well is abandoned, date of last production July 1964
Was permission obtained from the Conservation Division or its agents before plugging was commenced? Yes

Name of Conservation Agent who supervised plugging of this well Hugh Scott
Producing formation Lower Morrow Depth to top 5310 Bottom 5406 Total Depth of Well 5577 Feet
Show depth and thickness of all water, oil and gas formations.

OIL, GAS OR WATER RECORDS

CASING RECORD

FORMATION	CONTENT	FROM	TO	SIZE	PUT IN	PULLED OUT
Lower Morrow	Gas	5359	5369	8 5/8	1527'	
				5 1/2	5472'	3218'

Describe in detail the manner in which the well was plugged, indicating where the mud fluid was placed and the method or methods used in introducing it into the hole. If cement or other plugs were used, state the character of same and depth placed, from _____ feet to _____ feet for each plug set.
Filled hole with mud to 5230' and spotted 20 sxs cmt.; filled hole with mud and spotted 35 sxs cmt. from 700' to 600'; filled hole with mud and spotted 15 sxs cmt. at 45'

RECEIVED
STATE CORPORATION COMMISSION

AUG 10 1964

CONSERVATION DIVISION
Wichita, Kansas

(If additional description is necessary, use BACK of this sheet)
Name of Plugging Contractor Sergents Casing Pulling Service
Address 1546 Clay Court, Liberal, Kansas

STATE OF KANSAS, COUNTY OF SEWARD, ss.
S. H. Neithercoat, Supt. Drlg. & Prod. (employee of owner) or (owner or operator) of the above-described well, being first duly sworn on oath, says: That I have knowledge of the facts, statements, and matters herein contained and the log of the above-described well as filed and that the same are true and correct. So help me God.

(Signature) S. H. Neithercoat

P.O. Box 351, Liberal, Kansas
(Address)

SUBSCRIBED AND SWORN TO before me this 7th day of August, 1964

My commission expires _____

Donald L. Vangieson
Notary Public.

MY COMMISSION EXPIRES SEPT. 29, 1964

15-129-0055-0000

DRILLER'S LOG

WELL NAME: Carrington #244 WELL LOCATION: 1986 ft. East of West Line
 and 1300 ft North of South Line, S 08 E1, Sec. 24, Twp. 31S, Rge 41W,

COMPANY: Panhandle Eastern Pipe Line Company, Box #979, Liberal, Kansas

CONTRACTOR: Garvey Drilling Company, 211 East Third, Wichita, Kansas

DRILLING COMMENCED: 1/14/57
 DRILLING COMPLETED: 1/17/57
 WELL COMPLETED: 1/22/57
 WELL CONNECTED:

PRODUCTION INFORMATION: 265 MCF after treatment

SOURCE OF DATA: Driller's Report

ROTARY LOG

Description of Formation	Top	Bottom	FORMATIONS	Tops

STATE OF KANSAS
 STATE GEOLOGICAL SURVEY

11-06-64
 NOV 6 1964

CONSERVATION DIVISION
 WICHITA, KANSAS

Producing Formation

PERFORATIONS

5100'-05'; 5100'-11'; Spaced
5100'-60'

WELL TREATMENT RECORD

Acidized 1/19/57 w/300 gals 15% acid.
Acidized 1/23/57 w/300 gals 15% acid.
Acidized 1/24/57 w/300 gals 15% acid.
Fractured 1/27/57 w/5,000 gals acid free
2000' sand.

STATE OF KANSAS
 CONSERVATION DIVISION
 WICHITA, KANSAS