

STATE OF KANSAS
STATE CORPORATION COMMISSION


15-025-20176-0000

WELL PLUGGING RECORD

Give All Information Completely
Make Required Affidavit
Mail or Deliver Report to
Conservation Division
State Corporation Comm.
245 North Water
Wichita, KS 67202

Clark County, Sec. 15 Twp. 31S Rge. 24WE/W
Location as "NE/CNW $\frac{1}{4}$ SW $\frac{1}{4}$ " or footage from lines

C SSE SE SE
Lease Owner Imperial Oil Co.
Lease Name Denton Well No. 1-15
Office Address 720 Fourth Financial Center, Wichita
Character of Well (Completed as Oil, Gas or Dry Hole)
Dry Hole

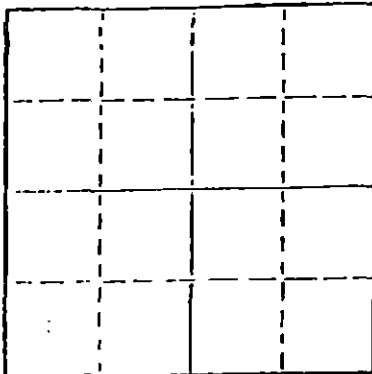

Locate well correctly on above
Section Plat

Date Well completed October 17, 1977
Application for plugging filed 19
Application for plugging approved 19
Plugging commenced October 27, 1977
Plugging completed October 27, 1977
Reason for abandonment of well or producing formation

Dry Hole
If a producing well is abandoned, date of last production 19

Was permission obtained from the Conservation Division or its agents before plugging was commenced? Yes

Name of Conservation Agent who supervised plugging of this well Clarence Thomas of GC
Producing formation Depth to top Bottom Total Depth of Well 5660'
Show depth and thickness of all water, oil and gas formations.

OIL, GAS OR WATER RECORDS

CASING RECORD

FORMATION	CONTENT	FROM	TO	SIZE	PUT IN	PULLED OUT
	Surface	0	683'	8-5/8"	683'	None
	Casing					

Describe in detail the manner in which the well was plugged, indicating where the mud fluid was placed and the method or methods used in introducing it into the hold. If cement or other plugs were used, state the character of same and depth placed, from feet to feet for each plug set.

Plugged Hole w/40 sax cement @ 680',
10 sax cement 40' to 3' below GL,
5 sax cement in rat hole.
completed @ 5:30 A.M.

Job F.C.E.I.S.
STATE CORPORATION COMMISSION

11-8-77

NOV 08 1977

CONSERVATION DIVISION
Wichita, Kansas

(If additional description is necessary, use BACK of this sheet)

Name of Plugging Contractor Sun Cementing, Great Bend, Kansas

STATE OF KANSAS

COUNTY OF SEDGWICK


, ss.

T. M. McCaul, Jr. of Sage Drilling Co., Inc. (employee of owner) of the above-described well, being first duly sworn on oath, says: That I have knowledge of the facts, statements, and matters herein contained and the log of the above-described well as filed and that the same are true and correct. So help me God.

(Signature)

T. M. McCaul Jr.

500 Bitting Bldg., Wichita, Kansas
(Address)

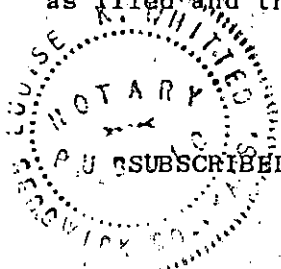

SUBSCRIBED AND SWORN TO before me this 7th day of November, 1977.

Louise K. Whitted
Louise K. Whitted - Notary Public.

My commission expires November 26, 1978.

DRILLERS LOG

DENTON NO. 1-15

15-025-20176-0000

CASING RECORD:	OPERATOR: Imperial Oil Co.	DESCRIPTION:
8-5/8" set @ 683' w/400 sax cement	CONTRACTOR: Sage Drilling Co.	C 3SE SE SE Sec. 15-31S-24W Clark County, Kansas
TOTAL DEPTH: 5660'	COMMENCED: October 17, 1977	ELEVATION: 2531KB
	COMPLETED: October 27, 1977	

<u>FORMATION</u>	<u>FROM</u>	<u>TO</u>	<u>REMARKS</u>
Red Bed & Clay	0	314	
Shale	314	2595	
Shale & Lime	2595	2805	
Lime & Shale	2805	5515	
Lime	5515	5535	Ran DST#1 @ 5535'
Lime	5535	5660	Logged Hole; D&A.

I certify that this is a true and correct copy of the log on the above captioned well to the best of my knowledge.

SAGE DRILLING CO., INC.

By *T. M. McCaul, Jr.*
T. M. McCaul, Jr.

RECEIVED
OIL CONSERVATION COMMISSION
NOV 08 1977
OIL CONSERVATION DIVISION
Topeka, Kansas



Subscribed and sworn to before me this 7th day of November, 1977.

Louise K. Whitted
Louise K. Whitted - Notary Public

My commission expires:
November 26, 1978.