


Give All Information Completely
Make Required Affidavit
Mail or Deliver Report to:
Conservation Division
State Corporation Commission
212 No. Market
Wichita, Kansas

WELL PLUGGING RECORD

NORTH

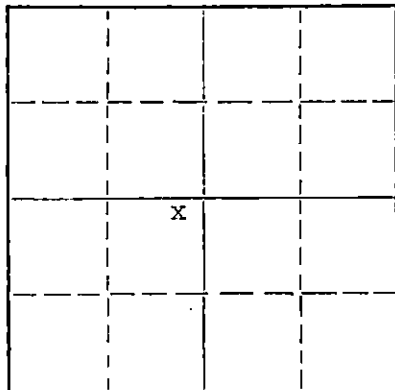

Locate well correctly on above Section Plat

Stevens County. Sec. 7 Twp. 31 Rge. 37 (E) (W)
Location as "NE/CNW/SE/SW" or footage from lines 2542.8' N F S and 2740' W F E Line
Lease Owner Panhandle Eastern Pipe Line Company
Lease Name Spikes Well No. 1-7
Office Address P. O. Box 828, Liberal, Kansas
Character of Well (completed as Oil, Gas or Dry Hole) Gas
Date well completed February 22 19 46
Application for plugging filed July 6 19 66
Application for plugging approved July 6 19 66
Plugging commenced July 7 19 66
Plugging completed July 11 19 66
Reason for abandonment of well or producing formation This well has been replaced by the Spikes No. 2-7
If a producing well is abandoned, date of last production 19
Was permission obtained from the Conservation Division or its agents before plugging was commenced? Yes

Name of Conservation Agent who supervised plugging of this well Ed Eves
Producing formation Hugoton Depth to top 2465 Bottom 2614 Total Depth of Well 2624 Feet
Show depth and thickness of all water, oil and gas formations.

OIL, GAS OR WATER RECORDS

CASING RECORD

FORMATION	CONTENT	FROM	TO	SIZE	PUT IN	PULLED OUT
Krider	Gas	2436	2500	10-3/4"	524	None
Winfield	Gas	2500	2578	7"	2417	
Ft. Riley	Gas	2578	2614	5-1/2"	218 liner	
				4-1/2"	2353	2353

Describe in detail the manner in which the well was plugged, indicating where the mud fluid was placed and the method or methods used in introducing it into the hole. If cement or other plugs were used, state the character of same and depth placed, from _____ feet to _____ feet for each plug set.

50 sacks cement from Total Depth to 2393' filled with mud from 2393' to 600' cemented with 40 sacks from 600' to 400' filled with mud from 400' to 100' cemented from 100' to 20' and filled with mud to surface.

Electric log not available

RECEIVED
STATE CORPORATION COMMISSION
JUL 15 1966
CONSERVATION DIVISION
Wichita, Kansas

(If additional description is necessary, use BACK of this sheet)

Name of Plugging Contractor Sargent Casing Pulling Service
Address Liberal, Kansas

STATE OF Kansas, COUNTY OF Seward, ss.
Jack P. Phillippe (employee of owner) or (owner or operator) of the above-described well, being first duly sworn on oath, says: That I have knowledge of the facts, statements, and matters herein contained and the log of the above-described well as filed and that the same are true and correct. So help me God.

(Signature) Jack P. Phillippe, Manager Drlg. & Prod.
P. O. Box 828, Liberal, Kansas
(Address)

SUBSCRIBED AND SWORN to before me this 13th day of July, 19 66

My commission expires September 13, 1966

Joan Taylor
JOAN TAYLOR Notary Public.