

STATE OF KANSAS
STATE CORPORATION COMMISSION

15-189-20145-00-00
Form CP-4


Give All Information Completely
Make Required Affidavit
Mail or Deliver Report to:
Conservation Division
State Corporation Commission
212 No. Market
Wichita, Kansas 67202

WELL PLUGGING RECORD

Stevens

County. Sec. 13 Twp. 31S, Rge. 39 (E) W (W)

Location as "NE/CNW/SW" or footage from lines 1250' FSL & 1250' FWL
Lease Owner AMOCO PRODUCTION COMPANY
Lease Name SECURITY ELEVATOR GAS UNIT "C" Well No. 2-A
Office Address P.O. Box 432 LIBERAL, KANSAS 67901
Character of Well (completed as Oil, Gas or Dry Hole) DRY HOLE
Date well completed 8-21 19 72
Application for plugging filed CONSERVATION AGENT CONTACTED 19
Application for plugging approved _____ 19
Plugging commenced 9-27 19 72
Plugging completed 9-27 19 72
Reason for abandonment of well or producing formation LOST CIRCULATION WHILE DRILLING. STUCK DRILL PIPE. COULD NOT RECOVER
If a producing well is abandoned, date of last production _____ 19
Was permission obtained from the Conservation Division or its agents before plugging was commenced? YES

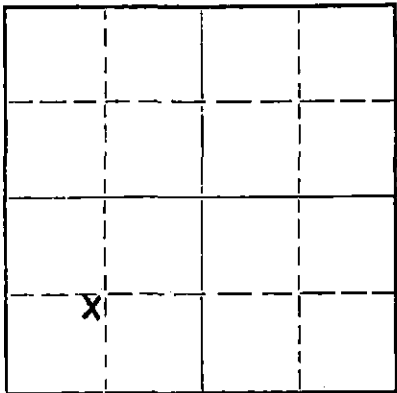

Locate well correctly on above Section Plot

Name of Conservation Agent who supervised plugging of this well MR. E. EVES
Producing formation _____ Depth to top _____ Bottom _____ Total Depth of Well 1706 Feet
Show depth and thickness of all water, oil and gas formations.

OIL, GAS OR WATER RECORDS

CASING RECORD

FORMATION	CONTENT	FROM	TO	SIZE	PUT IN	PULLED OUT
				<u>8 5/8</u>	<u>638</u>	<u>0</u>

Describe in detail the manner in which the well was plugged, indicating where the mud fluid was placed and the method or methods used in introducing it into the hole. If cement or other plugs were used, state the character of same and depth placed, from _____ feet to _____ feet for each plug set.

LOST CIRCULATION WHILE DRILLING 7 7/8" HOLE AT DEPTH OF 1706 FEET. 100 SK THIXOTROPIC CEMENT PUMPED TO BOTTOM OF HOLE, FOLLOWED WITH 100 SK LITE P02. SHUT DOWN 1 1/2 HRS. MIX AND PUMP AN ADDITIONAL 180 SK CEMENT. FILL HOLE AND 8 5/8 CASING FROM 1706 FEET TO SURFACE.

RECEIVED
STATE CORPORATION COMMISSION

OCT 11 1972 10-11-72


CONSERVATION DIVISION
Wichita, Kansas

(If additional description is necessary, use BACK of this sheet)
Name of Plugging Contractor HALLIBURTON COMPANY
Address P.O. Box 1431 - DUNCAN, OKLAHOMA 73533

STATE OF KANSAS, COUNTY OF SEWARD, ss.
J. W. VAUGHN (employee of owner) or (owner or operator) of the above-described well, being first duly sworn on oath, says: That I have knowledge of the facts, statements, and matters herein contained and the log of the above-described well as filed and that the same are true and correct. So help me God.

(Signature) J. W. VAUGHN
P.O. Box 432 LIBERAL, KANSAS 67901
(Address)

Subscribed and Sworn to before me this 6 day of October, 19 72

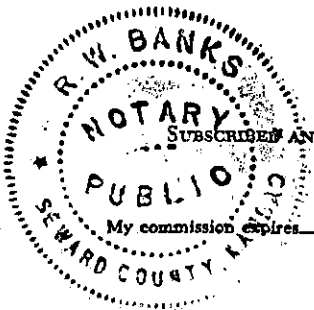

2-11-76

R.W. Banks
Notary Public.

FORMATION RECORD

DESCRIBE EACH FORMATION DRILLED. INDICATE THICKNESS, CONTENT AND WHETHER DRY, OR OIL, GAS, OR WATER BEARING.

FORMATION	TOP	BOTTOM	FORMATION	TOP	BOTTOM
SANDS	0	250			
SAND, RED BED	250	1510			
SAND	1510	1706			

