


WELL PLUGGING RECORD

Give All Information Completely
Make Required Affidavit
Mail or Deliver Report to:
Conservation Division
State Corporation Commission
800 Biting Building
Wichita, Kansas

STEVENS
STEPHENS

County. Sec. 28 Twp. 31 Rge. 35 (E) (W)

NORTH

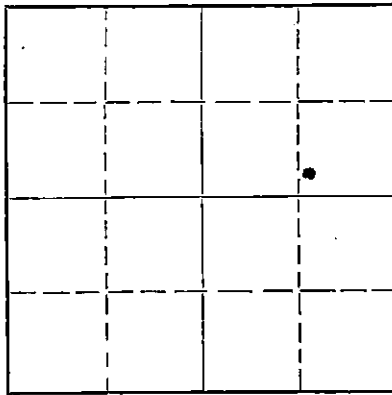

Locate well correctly on above
Section Plat

Location as "NE/CNW/SW" or footage from lines C SW NE
 Lease Owner Northern Natural Gas Producing Company
 Lease Name Droller - A Well No. 2
 Office Address Box 1069 Hugoton Kansas
 Character of Well (completed as Oil, Gas or Dry Hole) Dry Hole
 Date well completed 4-15-62 (Approx) 1962
 Application for plugging filed 4-15- 1963
 Application for plugging approved 4-15 (oral) 1963
 Plugging commenced 4-16- 1963
 Plugging completed 4-16- 1963
 Reason for abandonment of well or producing formation No producing formation found other than the Hugoton
 If a producing well is abandoned, date of last production 19
 Was permission obtained from the Conservation Division or its agents before plugging was commenced? yes

Name of Conservation Agent who supervised plugging of this well Hugh Scott
 Producing formation _____ Depth to top _____ Bottom _____ Total Depth of Well 6150 Feet
 Show depth and thickness of all water, oil and gas formations.

OIL, GAS OR WATER RECORDS

CASING RECORD

FORMATION	CONTENT	FROM	TO	SIZE	PUT IN	PULLED OUT
<u>Hugoton</u>	<u>Gas</u>	<u>2600</u>	<u>2850</u>	<u>8 5/8</u>	<u>672</u>	<u>None</u>

Describe in detail the manner in which the well was plugged, indicating where the mud fluid was placed and the method or methods used in introducing it into the hole. If cement or other plugs were used, state the character of same and depth placed, from _____ feet to _____ feet for each plug set.

MADE AN ATTEMPT TO WASH DOWN HOLE WITH TUBING BUT COULD NOT GET THROUGH THE GELLARITTA SAND.
PUMPED 35 SKS OF CEMENT W/PUMP TRUCK @ 604' - 604' TO 504' CEMENT - MUD TO 40' AND PUMPED 15 SKS @ 40' - CEMENT FROM 40' TO BASE OF GELLAR. CUT SURFACE CASING OFF 4' BELOW GROUND LEVEL AND WELD GAP ON SAME.

RECEIVED
STATE CORPORATION COMMISSION

APR 18 1963

CONSERVATION DIVISION
Wichita, Kansas

(If additional description is necessary, use BACK of this sheet)
 Name of Plugging Contractor SARGENTS CASING Pulling Service
 Address 121 West 9th St. Liberal Kansas

STATE OF KANSAS, COUNTY OF SEWARD, ss.
Robert Sargent (employee of owner) or (owner or operator) of the above-described well, being first duly sworn on oath, says: That I have knowledge of the facts, statements, and matters herein contained and the log of the above-described well as filed and that the same are true and correct. So help me God.

(Signature) Robert Sargent
121 W 9th Liberal Kansas
 (Address)

SUBSCRIBED AND SWORN TO before me this 16th day of April, 1963

My commission expires 11-5-66

Melene Leasing
Notary Public

BROLLIER "A" 2

Rigged up Rotary Tools 2/21/62

Ran 23 Jts. (671.82') 8 5/8" Casing
set @ 685' KB Cemented W/450 sx. Pozmix
2% Calcium Chloride

Tore down Rotary Tools 3-15-62

15-189-10030-0000

<u>FORMATION</u>	<u>FROM</u>	<u>TO</u>
Surface Clay	0	60
Sand Gravel & Clay	60	530
Shale & Shells	530	685
Redbed & Sand	685	1422
Shale & Shells	1422	2180
Shale	2180	2343
Lime W/ Shale Stks.	2343	2490
Shale & Lime	2490	2816
Lime W/ Shale	2816	2990
Lime	2990	3057
Lime & Shale	3057	3162
Lime	3162	3255
Lime & Shale	3255	3540
Shale & Chalk	3540	3760
Chalky Lime & Shale	3760	3850
Lime & Shale	3850	4035
Shale & Chalk	4035	4107
Lime & Shale	4107	4474
Shale	4474	4513
Lime	4513	5435
Lime & Shale	5435	5510
Lime	5510	5580
Shale	5580	5692
Lime & Shale	5692	5832
Shale	5832	5912
Lime & Shale	5912	6037
Lime & Sand	6037	6077
Lime	6077	6150 T. D.

RECEIVED
 STATE CORPORATION COMMISSION
 APR 19 1963
 CONSERVATION DIVISION
 Wichita, Kansas

I, R. G. Schmidt, do hereby certify that the foregoing log is true and correct, to the best of my knowledge and belief.

R. G. Schmidt

Subscribed and sworn to before me this 17th day of April, 1963

George F. Cox
(Notary Public)

My Commission expires: June 9, 1966