

Give All Information Completely
Make Required Affidavit
Mail or Deliver Report to:
Conservation Division
State Corporation Commission
212 No. Market
Wichita, Kansas

WELL PLUGGING RECORD

Stevens County. Sec. 13 Twp. 31S Rge. 39 (E) 39 (W)

Location as "NE/CNW/SW" or footage from lines 2640' FEL X 1250' FSL

Lease Owner Amoco Production Company

Lease Name Security Elevator Gas Unit "C" Well No. 2

Office Address P. O. Box 432 - Liberal, Kansas 67901

Character of Well (completed as Oil, Gas or Dry Hole) Dry Hole

Date well completed 5-30 19 72

Application for plugging filed Conservation Agent contacted 19

Application for plugging approved 19


Plugging commenced 6-3 19 72

Plugging completed 6-3 19 72

Reason for abandonment of well or producing formation Lost circulation while drilling, could not regain.

If a producing well is abandoned, date of last production 19

Was permission obtained from the Conservation Division or its agents before plugging was commenced? Yes

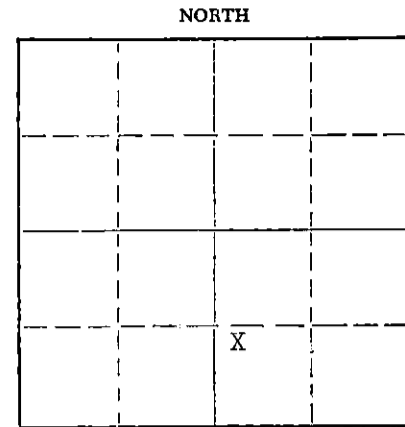

Locate well correctly on above Section Plat

Name of Conservation Agent who supervised plugging of this well Mr. E. Eves

Producing formation _____ Depth to top _____ Bottom _____ Total Depth of Well 1455 Feet

Show depth and thickness of all water, oil and gas formations.

OIL, GAS OR WATER RECORDS

CASING RECORD

FORMATION	CONTENT	FRDM	TD	SIZE	PUT IN	PULLED OUT
				8-5/8	639	0

Describe in detail the manner in which the well was plugged, indicating where the mud fluid was placed and the method or methods used in introducing it into the hole. If cement or other plugs were used, state the character of same and depth placed, from _____ feet to _____ feet for each plug set.

Lost circulation while drilling 7-7/8" hole at depth of 1455. 100 sacks Thixotropic cement pumped to bottom of hole, followed with 100 sacks Lite Poz Glass "H". Shut down 2-1/2 hours. Mix and pump additional 280 sacks cement. Fill pipe from 1455' to surface.

RECEIVED
STATE CORPORATION COMMISSION
JUN 23 1972
CONSERVATION DIVISION
Wichita, Kansas

(If additional description is necessary, use BACK of this sheet)

Name of Plugging Contractor Halliburton Company

Address P. O. Box 1431 - Duncan, Oklahoma 73533


STATE OF Kansas, COUNTY OF Seward, ss. J. W. Vaughn

(employee of owner) or (owner or operator) of the above-described well, being first duly sworn on oath, says: That I have knowledge of the facts, statements, and matters herein contained and the log of the above-described well as filed and that the same are true and correct. So help me God.

(Signature) J. W. VAUGHN Area Admn. Supv.

P. O. Box 432 - Liberal, Kansas 67901
(Address)

Subscribed and sworn to before me this 20th day of June, 19 72

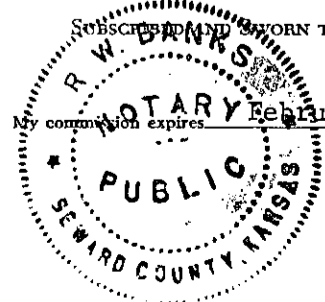

R. W. Banks
Notary Public.

FORMATION RECORD

DESCRIBE EACH FORMATION DRILLED. INDICATE THICKNESS, CONTENT AND WHETHER DRY, OR OIL, GAS, OR WATER BEARING.

FORMATION	TOP	BOTTOM	FORMATION	TOP	BOTTOM
Sand	0	257			
Sand - Red Bed	257	1455			

Lost circulation at 1427. Mix mud wash down to 1423, lost return. Mix lost circulation material still no return. Dry drill to 1455 with no return. PXA with 100 sacks Thixotropic, Tail with 100 sacks Poz "H". Shut down 2-1/2 hours. Mix and pump additional 280 sacks cement. Fill pipe 1455 to surface.