


Give All Information Completely
Make Required Affidavit
Mail or Deliver Report to:
Conservation Division
State Corporation Commission
212 No. Market
Wichita, Kansas

WELL PLUGGING RECORD

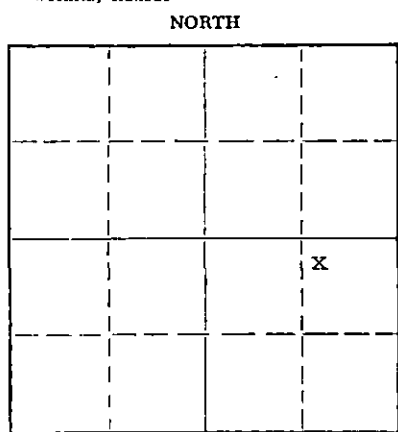

Locate well correctly on above Section Plat

Stevens County, Sec. 22 Twp. 31S Rge. (E)39 (W)
Location as "NE/CNW/SW" or footage from lines 2620 FSL X 1280 FEL
Lease Owner Amoco Production Company
Lease Name Margaret E. Prichard Well No. 2
Office Address P. O. Box 432 - Liberal, Kansas 67901
Character of Well (completed as Oil, Gas or Dry Hole) Lost Hole
Date well completed 19
Application for plugging filed Conservation agent contacted 19
Application for plugging approved 19
Plugging commenced April 28, 19 72
Plugging completed April 28, 19 72
Reason for abandonment of well or producing formation Lost circulation while drilling. Could not regain.
If a producing well is abandoned, date of last production 19
Was permission obtained from the Conservation Division or its agents before plugging was commenced? Yes

Name of Conservation Agent who supervised plugging of this well Mr. E. Eves
Producing formation Depth to top Bottom Total Depth of Well 1728 Feet
Show depth and thickness of all water, oil and gas formations.

OIL, GAS OR WATER RECORDS

CASING RECORD

FORMATION	CONTENT	FROM	TO	SIZE	PUT IN	PULLED OUT
				8-5/8	622	0

Describe in detail the manner in which the well was plugged, indicating where the mud fluid was placed and the method or methods used in introducing it into the hole. If cement or other plugs were used, state the character of same and depth placed, from feet to feet for each plug set.
Lost hole while drilling 7-5/8" hole at depth of 1728'. 100 sacks of Thixotropic cement pumped to bottom of hole. This was followed with 380 sacks of lite poz. Hole was completely filled from 1728' (TD) to surface.

RECEIVED
STATE CORPORATION COMMISSION
MAY 15 1972 5-15-72
CONSERVATION DIVISION
Wichita, Kansas

(If additional description is necessary, use BACK of this sheet)
Name of Plugging Contractor Halliburton Company
Address P. O. Box 1431 - Duncan, Oklahoma 73533


STATE OF Kansas, COUNTY OF Seward, ss.
J. W. VAUGHN (employee of owner) or (owner or operator) of the above-described

well, being first duly sworn on oath, says: That I have knowledge of the facts, statements, and matters herein contained and the log of the above-described well as filed and that the same are true and correct. So help me God.

(Signature) J. W. VAUGHN

P. O. Box 432 - Liberal, Kansas 67901 (Address)

Sworn to before me this 10th day of May, 19 72

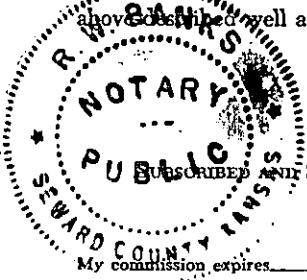

My commission expires February 11, 1976
R. W. BANKS Notary Public.

FORMATION RECORD

DESCRIBE EACH FORMATION DRILLED. INDICATE THICKNESS, CONTENT AND WHETHER DRY, OR OIL, GAS, OR WATER BEARING.

FORMATION	TOP	BOTTOM	FORMATION	TOP	BOTTOM
Sand	0	530			
Red Bed	530	623			
Red Bed - Sand	623	1625			
Sand - Shale	1625	1728 TD			

Lost circulation at 1625'. Stuck drill pipe at 1697', unable to pull pipe. PXA with 100 sacks Thixotropic cement, followed with 380 sacks lite pozmix. Cemented from 1728' to surface.