

TYPE OR PRINT  
NOTICE: Fill out completely  
and return to Cons. Div.  
office within 30 days.

LEASE OPERATOR AMOCO PRODUCTION COMPANY

ADDRESS P O BOX 800, ROOM 925, DENVER, CO 80201

PHONE (803) 830-5130 OPERATORS LICENSE NO. 5952

Character of Well GAS

(Oil, Gas, D&A, SWD, Input, Water Supply Well)

The plugging proposal was approved on 9-9-94 / 9-15-94 (date)

by STEVE Pfeifer / GLENN BARLOW on Location (KCC District Agent's Name).

Is ACO-1 filled? YES If not, is well log attached?

Producing Formation COUNCIL GROVE Depth to Top Bottom T.D. 2907

Show depth and thickness of all water, oil and gas formations.

OIL, GAS OR WATER RECORD | CASING RECORD

Formation	Content	From	To	Size	Put in	Pulled out
SURFACE				8 / 58	723	

Describe in detail the manner in which the well was plugged, indicating where the mud fluid was placed and the method or methods used in introducing it into the hole. If cement or other plug were used, state the character of same and depth placed, from feet to feet each set

ATTACHED

Name of Plugging Contractor HALIBURTON License No.

Address

NAME OF PARTY RESPONSIBLE FOR PLUGGING FEES: AMOCO PRODUCTION COMPANY

STATE OF COLORADO COUNTY OF DENVER, ss.

M.M. Hill (Employee of Operator) or (Operator) of

above-described well, being first duly sworn on oath, says: That I have knowledge of the facts statements, and matters herein contained and the log of the above-described well as filed and the same are true and correct, so help me God.

(Signature) M.M. Hill

(Address)


SUBSCRIBED AND SWORN TO before me this 28th day of September, 1994

Susan Callaway  
Notary Public  
STATE CORPORATION COMMISSION

My Commission Expires: August 2, 1998

9-29-94 SEP 29 1994 Form 02-4 Revised 05-88

$4\frac{1}{2}''$  9.5# = .0912 cft/ft (752) = 69cf ÷ 1.64 cft/sx = 42sx  
 $4\frac{1}{2}''$  9.5# x  $9\frac{5}{8}$  32.3# = .3314 cft/ft (752) = 249cf ÷ 1.64 cft/sx = 152sx 316bl water  
 9661 water

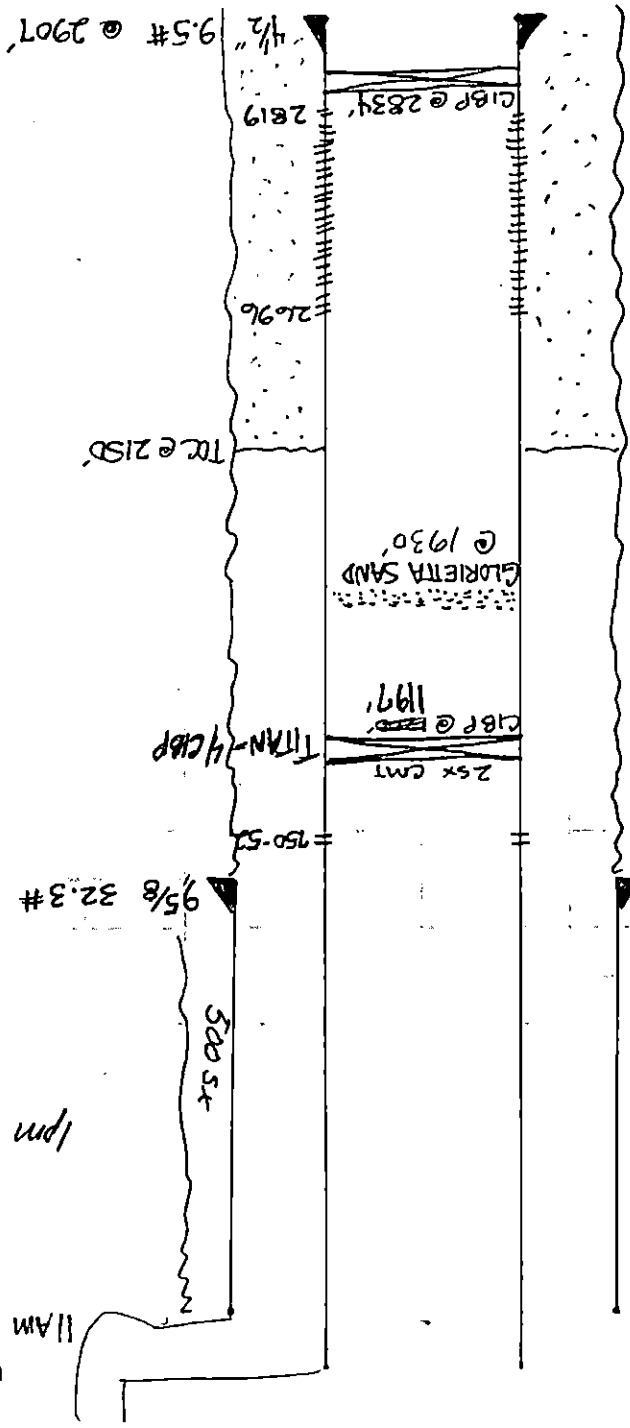

Circulated cement to surface

FL @ 600'

TOTAL CMT 250SX  
TOTAL WATER 100661

- 1) RIT & SP - THE SAND 1930'
- 2) SET CIBP @ 1197'
- 3) Dump 25x cmt
- 4) ~~PERF 750-752~~
- 5) PERF 750-752
- 6) CMT x 250SX CMT (516bl water)
- 7) Dig out well head
- 8) Cut-off
- 9) Weld on cnp

THURS SEPT 15

From DERMOT Road & Bigbow Road ST - 2N - 1W - 1/2 N - 1/2 W - 1/4 S - W INTO

SUBJECT: MORGAN GU #1  
 SEC 7-31S-39W MORTON, County  
 Date: \_\_\_\_\_  
 By: \_\_\_\_\_

ENGINEERING CHART

Amoco Production Company

Sheet No. 1512 9-00672-0000  
File \_\_\_\_\_