

STATE OF KANSAS
STATE CORPORATION COMMISSION

Form CP-4


Give All Information Completely
Make Required Affidavit
Mail or Deliver Report to:
Conservation Division
State Corporation Commission
211 No. Broadway
Wichita, Kansas

WELL PLUGGING RECORD

Sumner County, Sec. 28 Twp. 30 Rge. (E) 3 (W)

Location as "NE/CNW/SW" or footage from lines NW SW
Lease Owner Shawver Armour, Inc.
Lease Name Thew Well No. 1
Office Address 817 Central Bldg., Wichita, Ks.
Character of Well (completed as Oil, Gas or Dry Hole) Dry Hole
Date well completed August 6 1965
Application for plugging filed August 6 1965
Application for plugging approved August 6 1965
Plugging commenced August 6 1965
Plugging completed August 6 1965
Reason for abandonment of well or producing formation

NORTH

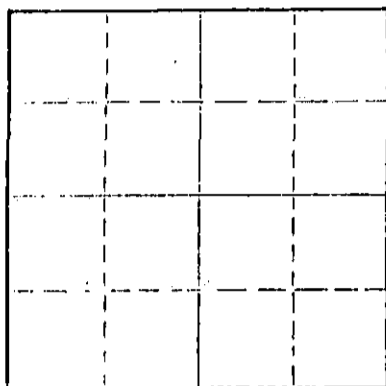

Locate well correctly on above Section Plat

If a producing well is abandoned, date of last production 19
Was permission obtained from the Conservation Division or its agents before plugging was commenced? yes

Name of Conservation Agent who supervised plugging of this well Paul Turpin
Producing formation Depth to top Bottom Total Depth of Well 4337 Feet
Show depth and thickness of all water, oil and gas formations.


OIL, GAS OR WATER RECORDS

CASING RECORD

FORMATION	CONTENT	FROM	TO	SIZE	PUT IN	PULLED OUT
surface	water	-0-	213'	8 5/8"	213'	none

Describe in detail the manner in which the well was plugged, indicating where the mud fluid was placed and the method or methods used in introducing it into the hole. If cement or other plugs were used, state the character of same and depth placed, from feet to feet for each plug set.

Mudded hole with 40 Vis mud to 225'
Added 1/2 sx hulls - Set a dry hole plug
Added 20 sx cement
Mudded hole from this point to 30'
Added 1/4 sx hulls - set a plug
Added 8 sx Cement.
Mudded rat hole to 8 ft of surface
and added 2 sx cement

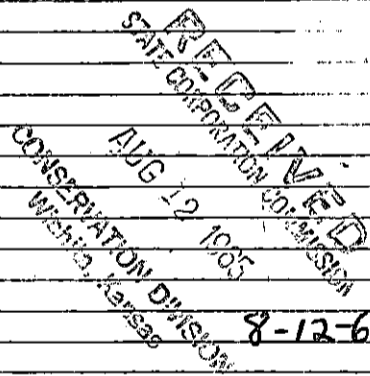

(If additional description is necessary, use BACK of this sheet)
Name of Plugging Contractor Shawver Armour, Inc.
Address 817 Central Building, Wichita, Kansas

STATE OF KANSAS COUNTY OF SEDGWICK, ss.
James M. Armour (employee of owner) or (owner or operator) of the above-described

well, being first duly sworn on oath, says: That I have knowledge of the facts, statements, and matters herein contained and the log of the above-described well as filed and that the same are true and correct. So help me God.

(Signature) James M. Armour
James M. Armour, 817 Central Bldg.
Wichita, Kansas

Subscribed and Sworn to before me this 10th day of August, 1965

My commission expires December 10, 1967

Claire Jones
Claire Jones Notary Public.

DRILLER'S LOG

28-30-3W

FARM NAME: Thew #1 LOCATION: NW SW Sec 28-30-3W
 Sumner County, Ks.
 CONTRACTOR: Shawver Armour, Inc.
 OWNER: Shawver Armour, Inc. ELEVATION: 1353 K.B.
 COMMENCED: July 23, 1965 COMPLETED: August 6, 1965
 CASING RECORD: Set 213' 8 5/8" w/165 sx cement & 4 sx CC

FORMATION:

TOPS:

Red Bed 70
 Red & Gray Shale 213
 Shale & Lime 765
 Lime & Shale 1185
 Lime 1335
 Shale & Lime 1575
 Shale & Lime Stringers 1845
 Shale & Lime 2045
 Shale 2335
 Shale & Lime 2963
 Stalnaker Sand 3054
 Shale & Lime 3248
 K C Lime 3303
 Lime 3494
 Lime & Shale 3711
 Shale & Lime 3757
 Lime & Shale 3871
 Mississippian Lime 3923
 Lime 4038
 Miss Lime & Chert/Chat 4155
 Lime 4223
 Kinderhook 4303
 Simpson Sand 4337

Stalnaker 2963
 Kansas City 3248
 B. Kansas City 3486
 Mississippian 3871
 Kinderhook 4223
 Simpson Sand 4303

Rotary Total Depth 4337

STATE OF KANSAS }
 SEDGWICK COUNTY } ss

I, James M. Armour, do hereby certify that the above log is a true and correct copy of the above captioned well as shown on the daily drilling reports.

SHAWVER ARMOUR, INC.

BY James M. Armour
 James M. Armour

Subscribed and sworn to before me this 10th day of August, 1965.

My commission expires December 10th, 1967

Claire Jones
 Claire Jones Notary Public

RECEIVED
 STATE CORPORATION COMMISSION
 AUG 12 1965
 CONSERVATION DIVISION
 Wichita, Kansas