


Give All Information Completely  
Make Required Affidavit  
Mail or Deliver Report to:  
Conservation Division  
State Corporation Commission  
211 No. Broadway  
Wichita, Kansas

WELL PLUGGING RECORD

Kingman County, Sec. 17 Twp. 30S Rge. 5 (E) (W) X  
Location as "NE/CNW&SW" or footage from lines C of SW SW  
Lease Owner Mill Drilling Company, Inc.  
Lease Name TERNES Well No. 1  
Office Address 1625 Wichita Plaza Building Wichita, Kansas 67210  
Character of Well (completed as Oil, Gas or Dry Hole)  
Date well completed 19  
Application for plugging filed 9-15-64 19  
Application for plugging approved 9-16-64 19  
Plugging commenced 9-16-64 19  
Plugging completed 9-19-64 19  
Reason for abandonment of well or producing formation  
Dry

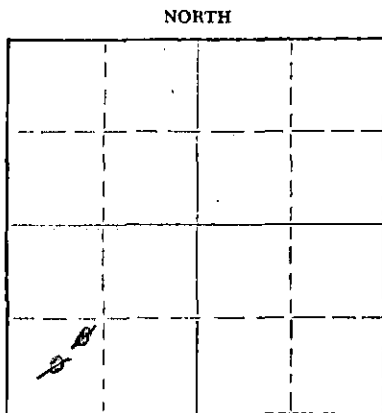

Locate well correctly on above  
Section Flat

If a producing well is abandoned, date of last production 19  
Was permission obtained from the Conservation Division or its agents before plugging was commenced? Yes

Name of Conservation Agent who supervised plugging of this well Archie V. Elving  
Producing formation Depth to top Bottom Total Depth of Well 1562 Feet  
Show depth and thickness of all water, oil and gas formations.

OIL, GAS OR WATER RECORDS

CASING RECORD

FORMATION	CONTENT	FROM	TO	SIZE	PUT IN	PULLED OUT
				8 5/8	213	None
				1 1/2	None	3025
					3705	

Describe in detail the manner in which the well was plugged, indicating where the mud fluid was placed and the method or methods used in introducing it into the hole. If cement or other plugs were used, state the character of same and depth placed, from feet to feet for each plug set.

Cleaned out cellar.  
Rigging up unit.  
Finished rigging up. Working pipe. Sanded to 3625'. Dumped 3 sacks of cement. Shot well at 3010'. Pulling pipe.  
Pulling pipe. Plugging well at 250'. Build 10' rock bridge. Dumped 25 sacks of cement. Mudded to 40'. Build 10' rock bridge. Capped well with 10 sacks.

RECEIVED  
STATE CORPORATION COMMISSION  
SEP 23 1964  
CONSERVATION DIVISION  
Wichita, Kansas

(If additional description is necessary, use BACK of this sheet)  
Name of Plugging Contractor Forbes Casing Pulling, Inc.  
Address P. O. Box 221 Great Bend, Kansas

STATE OF Kansas, COUNTY OF Barton, ss.  
J. O. Forbes (employee of owner) or (owner or operator) of the above-described

well, being first duly sworn on oath, says: That I have knowledge of the facts, statements, and matters herein contained and the log of the above-described well as filed and that the same are true and correct. So help me God.

(Signature) J. O. Forbes  
P. O. Box 221 Great Bend, Kansas  
(Address)

SUBSCRIBED AND SWORN TO before me this 22 day of September, 19 64

My commission expires May 27, 1965 Notary Public.

R O T A R Y D R I L L E R ' S L O G

COMPANY: Mull Drilling Co., Inc. ROTARY DRILLING COMMENCED: 5-25-64  
 Wichita, Kansas  
 CONTRACTOR: Mull Drilling Co., Inc. ROTARY DRILLING COMPLETED: 6-8-64  
 Wichita, Kansas  
 CASING RECORD: Set 243' 8 5/8" Surf.Csg. LOCATION: #1 Ternes  
 w/175 Sx. C SW SW 17-30S-5W  
 Set 3705' 4 1/2" csg w/150 Sx. Kingman County, Kansas

(Figures indicate bottom of formation; measurements from top of Rotary Bushing.)

475' Red bed and Shale  
 1225' Red bed & Shale w/lime  
 1837' Shale w/lime  
 2404' Sandy Lime & Shale  
 2680' Shale w/Lime  
 3398' Sandy Lime & Shale  
 4102' Limw & Shale  
 4320' Cherty Lime & Shale  
 4562' Lime & Shale and Total Depth

RECEIVED  
 STATE CORPORATION COMMISSION  
 SEP 14 1964  
 9-14-64  
 CONSERVATION DIVISION  
 Wichita, Kansas

I hereby certify that this is a true and correct copy of the above log to the best of my knowledge.

MULL DRILLING COMPANY, INC.

*Joseph B. Brungardt, Jr.*  
 Joseph B. Brungardt, Jr.

STATE OF KANSAS )  
 )  
 COUNTY OF SEDGWICK )

Subscribed and sworn before me  
 this 30th day of June, 1964.

*Lola L. Foster*

Lola L. Foster, Notary Public

My commission expires April 17, 1966.

