


Give All Information Completely
Make Required Affidavit
Mail or Deliver Report to:
Conservation Division
State Corporation Commission
212 No. Market
Wichita, Kansas

WELL PLUGGING RECORD

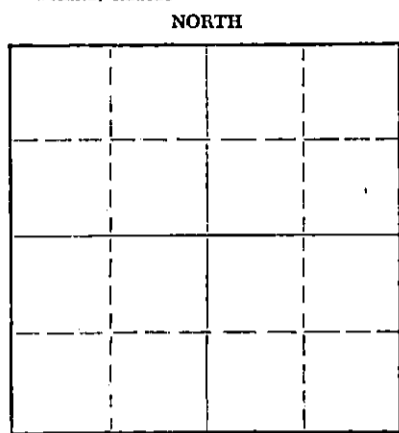

Locate well correctly on above
Section Plat

Kingman County, Sec. 8 Twp. 30S Rge. (E) 5 (W)
Location as "NE/CNWxSWx" or footage from lines SW/4-SE/4
Lease Owner Barbara Oil Company
Lease Name Schrag Well No. 1
Office Address 509 Union Center Bldg. Wichita, Kans. 67202
Character of Well (completed as Oil, Gas or Dry Hole) Dry Hole
Date well completed July 2 19 69
Application for plugging filed July 2 (Verbal) 19 69
Application for plugging approved July 2 19 69
Plugging commenced July 2 19 69
Plugging completed July 2 19 69
Reason for abandonment of well or producing formation Hole dry

If a producing well is abandoned, date of last production - 19 -
Was permission obtained from the Conservation Division or its agents before plugging was commenced? Yes

Name of Conservation Agent who supervised plugging of this well Mr. Ralph Warren
Producing formation _____ Depth to top _____ Bottom _____ Total Depth of Well 4190 Feet
Show depth and thickness of all water, oil and gas formations.

OIL, GAS OR WATER RECORDS

CASING RECORD

FORMATION	CONTENT	FROM	TO	SIZE	PUT IN	PULLED OUT
Sand		0	150	8 5/8	150	None
Shale		150	252	8 5/8	252	None

RECEIVED
STATE CORPORATION COMMISSION
JUL 10 1969
CONSERVATION DIVISION
Wichita, Kansas

Describe in detail the manner in which the well was plugged, indicating where the mud fluid was placed and the method or methods used in introducing it into the hole. If cement or other plugs were used, state the character of same and depth placed, from _____ feet to _____ feet for each plug set.

Filled hole with mud & 1/2 sack hulls. Set plug at 250' and put in 25 sacks of cement.
Filled hole with mud & 1/2 sack hulls. Set 2nd plug at 40 feet and put 10 10 sacks of cement to bottom of cellar. Put 2 sacks of cement in rathole. Job completed at 12:00 midnight July 2, 1969 by Mr. Ralph Warren, State Pluggers of Pratt, Kansas.

(If additional description is necessary, use BACK of this sheet)

Name of Plugging Contractor Gabbert-Jones, Inc.
Address 830 Sutton Place, Wichita, Kansas 67202

STATE OF Kansas, COUNTY OF Sedgwick, ss.
R. Douglas Myers (employee of owner) or (owner or operator) of the above-described well, being first duly sworn on oath, says: That I have knowledge of the facts, statements, and matters herein contained and the log of the above-described well as filed and that the same are true and correct. So help me God.

(Signature) R. Douglas Myers
509 Union Center Wichita, Ks. 67202
(Address)

SUBSCRIBED AND SWORN TO before me this 9th day of July, 19 69

My commission expires August 12, 1971

Doris Oglesbee
Doris Oglesbee Notary Public.

