


STATE OF KANSAS
STATE CORPORATION COMMISSION
200 Colorado Derby Bldg.
Wichita, Kansas 67202

Form CP-4
Rev. 12-15-80

WELL PLUGGING RECORD

Give All Information Completely
Make Required Affidavit

COUNTY KINGMAN SEC. 8 TWP. 10S RGE. 5W E/W
Location as in quarters or footage from lines:
C NE NW

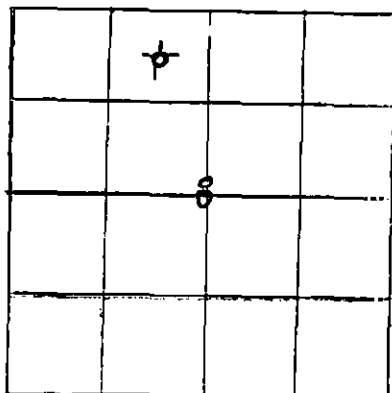

Locate Well
correctly on above
Section Platt.

Lease Owner American Energies Corporation
Lease Name Kimberlin Well No. 1
Office Address 575 Fourth Financial Center, Wichita, KS 67202
Character of Well (Completed as Oil, Gas or Dry Hole): Dry Hole
Date Well Completed June 9, 1982
Application for plugging filed June 9, 1982
Plugging commenced June 9, 1982
Plugging completed June 9, 1982
Reason for abandonment of well or producing formation _____

Was permission obtained from the Conservation Division or it's
Agent's before plugging was commenced? yes

Name of Conservation Agent who supervised plugging of this well Maurice Leslie

Producing formation _____ Depth to top _____ bottom _____ T.D. 3825

Show depth and thickness of all water, oil and gas formations.

OIL, GAS OR WATER RECORDS

Casing Record

Formation	Content	From	To	Size	Put in	Pulled Out
Surface	shale	0	250	8-5/8"	245	none
	cemented w/200 sx	60/40	posmix, 2%gel, 3% cc,			
	down 1:30 a.m. 6-2-82		by Sun; cement did circ.			

Describe in detail the manner in which the well was plugged, indicating where the mud fluid was placed and the method or methods used in introducing it into the hold. If cement or other plugs were used, state the character of same and depth placed, from _____ feet to _____ feet for each plug set.

Plugged as follows with 125 sx of common, 2%gel, 3%cc
60 sx @ 650'
40 sx @ 350'
10 sx & plug & bridge at 40'
10 sx in rat hole
Plug down at 9 p.m. 6-9-82 by Sun.


RECEIVED
STATE CORPORATION COMMISSION
JUN 17 1982
6-17-82
CONSERVATION DIVISION
WICHITA, KANSAS

(If additional description is necessary, use BACK of this sheet)

Name of Plugging Contractor Husky Drilling Co., Inc.

STATE OF KANSAS COUNTY OF SEDGWICK, ss.
Jon T. Williams, Jr. (employee of owner) or (owner or operator) of the
above-described well, being first duly sworn on oath, says: That I have knowledge of the
facts, statements, and matters herein contained and the log of the above-described well as
filed and that the same are true and correct. So help me God.

(Signature) [Signature]
200 E. First, Suite 500, Wichita, KS
(Address)

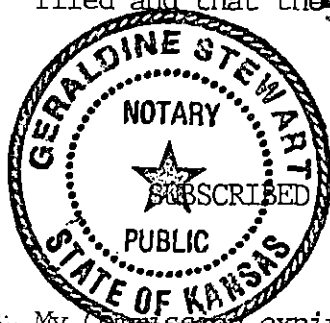

SUBSCRIBED AND SWORN TO before me this 9th day of June, 19 82

Geraldine Stewart
Geraldine Stewart Notary Public.

My Commission expires: January 14, 1985