

STATE CORPORATION COMMISSION OF KANSAS
OIL & GAS CONSERVATION DIVISION
WELL COMPLETION OR RECOMPLETION FORM
ACD-1 WELL HISTORY
DESCRIPTION OF WELL HISTORY

Operator: License # 5208
Name MOBIL OIL CORPORATION
Address P.O. BOX 5444
City/State/Zip DENVER, COLORADO 80217

Purchaser TA'D

Operator Contact Person B. R. MAYNARD
Phone (303) 298-2069

Contractor: License # 9137
Name UNIT EXPLORATION & DRILLING CO.

Wellsite Geologist J. PHILLIPS
Phone (303) 298-3653

Designate Type of Completion
 New Re-Entry Workover
 Oil SWD Temp Abd
 Gas Inj Delayed Comp.
 Dry Other (Core, Water Supply, etc.)

If DWDQ: old well info as follows;
Operator NA
Well Name _____
Comp. Date _____

WELL HISTORY

Drilling Method:
 Mud Rotary Air Rotary Cable
4-2-88 4-8-88 TA'D
Spud Date Date Reached TD Completion Date
6450' 3075'
Total Depth PBTD

Amount of Surface Pipe Set and Cemented at 1736 feet
Multiple Stage Cementing Collar Used? Yes No
If yes, show depth set _____ feet
If alternate 2 completion, cement circulated
from _____ feet depth to _____ w/ _____ SX cmt
Cement Company Name _____
Invoice # _____

API No. 15- 189-21153-0000
COUNTY STEVENS East
SW SE Sec 36 Twp 32S Rge 35 X West
660 Ft North from Southeast Corner of Section
1980 Ft West from Southeast Corner of Section
(Note: Locate well in section plat below)


Lease Name OWEN DOWDY WELL # 5

Field Name NORTH SHUCK

Producing Formation CHESTER

Elevation: Ground 2920' KB 2936'

SECTION PLAT

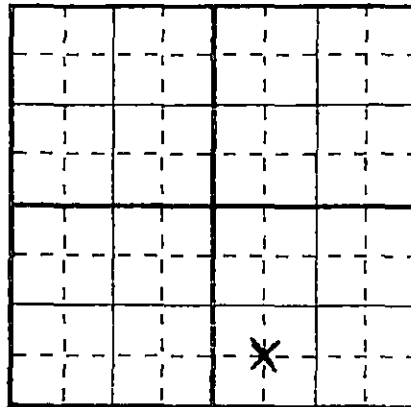

WATER SUPPLY INFORMATION

Disposition of Produced Water: _____ Disposal
Docket # TA'D _____ Repressuring

Questions on this portion of ACD-1 call:
Water Resources Board (913) 296-3717
Source of Water:
Division of Water Resources Permit# T88-172

Groundwater 825 Ft. North from Southeast Corner
(well) 1945 Ft. West from Southeast Corner of
Sec 36 Twp 32S Rge 35 East X West
 Surface Water _____ Ft. North from Southeast Corner
(Stream, pond etc) _____ Ft. West from Southeast Corner
Sec _____ Twp _____ Rge _____ East West
 Other (explain) _____
(purchased from city, R.W.D. #)

INSTRUCTIONS: This form shall be completed in triplicate and filed with the Kansas Corporation Commission, 200 Colorado Derby Building, Wichita, Kansas 67202, within 120 days of the spud date of any well. Rule 82-3-130, 82-3-107, and 82-3-106 apply.

Information on side two of this form will be held confidential for a period of 12 months if requested in writing and submitted with the form. See rule 82-3-107 for confidentiality in excess of 12 months.

One copy of all wireline logs and drillers time log shall be attached with this form. Submit cp-4 form with all plugged wells. Submit cp-111 from with all temporarily abandoned wells.

All requirements of statutes, rules and regulations promulgated to regulate the oil and gas industry have been fully complied with and the statements herein are complete and correct to the best of my knowledge.

Signature B. R. Maynard B. R. MAYNARD Q06

Title REGULATORY COMPLIANCE MANAGER Date 7-8-88

Subscribed and sworn to before me this 8th day of July

19 88
Notary Public George George

Date Commission Expires 1/3/91

K.C.C. OFFICE USE ONLY
 Letter of Confidentiality Attached
 Wireline Log Received
 Drillers Time Log Received
Distribution
 KCC SWD/Rep NGPA
 KGS Plug Other
(Specify)
7-11-88

JUL 11 1988
CONSERVATION DIVISION
Wichita, Kansas